

15-119-00189-0000

# WELL PLUGGING RECORD

OR


## FORMATION PLUGGING RECORD

Strike out upper line when reporting plugging of formations.

STATE OF KANSAS  
 STATE CORPORATION COMMISSION  
 Give All Information Completely  
 Make Required Affidavit  
 Mail or Deliver Report to:  
 Conservation Division  
 State Corporation Commission  
 800 Bittling Building  
 Wichita, Kansas

Meade County, Sec. 31 Twp. 33 S Rge. 29 (E) (W)

Location as "NE $\frac{1}{4}$ NW $\frac{1}{4}$ SW $\frac{1}{4}$ " or footage from lines. SW SE  
 Lease Owner White Eagle Oil Company  
 Lease Name ADAMS A Well No. A-2  
 Office Address First National Building Tulsa 3, Oklahoma  
 Character of Well - (completed as Oil, Gas or Dry Hole) Dryhole  
 Date well completed 1-19-1952 19  
 Application for plugging filed " " 19  
 Application for plugging approved " " 19  
 Plugging commenced 2-8-1952 19  
 Plugging completed 2-13-1952 19  
 Reason for abandonment of well or producing formation Dryhole

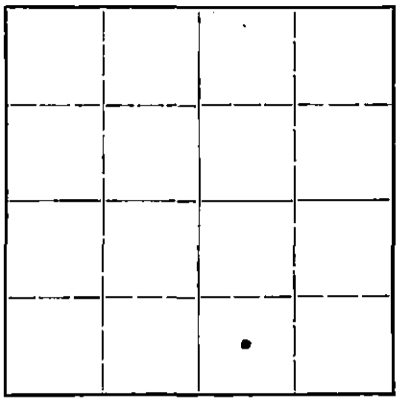

Locate well correctly on above Section Plat

If a producing well is abandoned, date of last production 19  
 Was permission obtained from the Conservation Division or its agents before plugging was commenced? Yes

Name of Conservation Agent who supervised plugging of this well C.D. Stough  
 Producing formation Depth to top Bottom Total Depth of Well 6280 Feet  
 Show depth and thickness of all water, oil and gas formations.

### OIL, GAS OR WATER RECORDS

### CASING RECORD

Formation	Content	From	To	Size	Put In	Pulled Out
Herington		2731	-60	13"OD	628	none
Krider		2803	-132	8-5/8"	2780	829"
Winfield		2850	-179			
Upper Fort Riley		2910	-239			
Lower Fort Riley		2984	-313			
Lansing		4516	-1845			
Marmaton		5226	-2655			
Morrow		5808	-3137			
Mississippi		5938	-3267			
St. Genevieve		6190	-3519			

Describe in detail the manner in which the well was plugged, indicating where the mud fluid was placed and the method or methods used in introducing it into the hole. If cement or other plugs were used, state the character of same and depth placed, from \_\_\_\_\_ feet to \_\_\_\_\_ feet for each plug set.  
13"OD 50# Casing set at 628' with 500 sacks of cement & 8-5/8" 32# casing set at 2780' with 300 sacks of cement.  
8-5/8" Casing shot off at 834'  
Cement plugs placed at 5544-5924 4044-4420 2548-2920  
Dumped 25 sacks of cement at 300', set rock bridge and finished mudding hole.  
Dumped 15 sacks of cement at surface.

STA.  
 FEB 29 1952  
 CO. 2-29-1952  
 CONSERVATION DIVISION

(If additional description is necessary, use BACK of this sheet)  
 Correspondence regarding this well should be addressed to Helmerich & Payne, Inc. % Harry Saye  
 Address First National Building, Tulsa 3, Oklahoma.

STATE OF Oklahoma, COUNTY OF Tulsa, ss.  
Harry Saye (employee of owner) or (owner or operator) of the above-described well,

being first duly sworn on oath, says: That I have knowledge of the facts, statements, and matters herein contained and the log of the above-described well as filed and that the same are true and correct. So help me God.

(Signature) Harry Saye  
First National Building Tulsa, Okla.  
 (Address)

SUBSCRIBED AND SWORN to before me this 25th day of February 19 52

My commission expires 8-29-1955. Notary Public.

21-871-s 9-15-6M  
**PLUGGING**  
 FILE SEC 31 T 33 R 290  
 PAGE 147 LINE 18

H. G. Adams "A" Well 2  
White Eagle Oil Company  
C SW SE Section 31-33S-29W  
Meade County, Kansas

Commenced: December 8, 1951  
Completed: January 19, 1952

Surface Sand & Shells	0	610
Redbed	610	800
Redbed & Lime Shells	800	875
Sand, Lime & Shells	875	1136
Lime Shells, Sand & Shale	1136	1128
Shale, Sand Shells & Salt	1128	1470
Lime Shells & Shale	1470	1555
Shale, Anhydrite & Salt	1555	1739
Shells, Shale & Sand	1739	1825
Shells, Shale & Salt	1825	1956
Shells & Shale	1956	2033
Shale & Shale Salt	2033	2077
Shale, Lime, Anhydrite	2077	2117
Shale, Lime Shells, Salt	2117	2250
Shale, Lime & Anhydrite	2250	2442
Anhydrite	2442	2491
Anhydrite, Lime & Shale	2491	2582
Anhydrite & Lime	2582	2660
Shale, Lime & Anhydrite	2660	2685
Anhydrite & Salt	2685	2715
Cherty Lime & Anhydrite	2715	2738
Lime & Anhydrite	2738	2765
Anhydrite & Chert	2765	2790
Lime	2790	2825
Lime & Shale	2825	3080
Lime	3080	3083
Shale & Lime	3083	3161
Lime	3161	3260
Shale & Lime	3260	3850
Shale	3850	4350
Broken Lime & Shale	4350	4354
Broken Lime	4354	4373
Shale & Lime	4373	4625
Lime	4625	4670
Lime & Shale	4670	4770
Lime	4770	4874
Shale & Lime	4874	4930
Lime	4930	4946
Lime & Shale	4946	5041
Lime	5041	5077
Shale & Lime	5077	5788
Sandy Shale	5788	5825
Shale & Lime	5825	5874
Lime	5874	5910
Lime & Shale	5910	5914
Lime	5914	5950
Shale & Lime	5950	5992
Lime	5992	6041
Shale & Lime	6041	6200
TOTAL DEPTH	6200	

CASING RECORD

Set 13" Casing @ 620' with 500 sacks  
Set 8-5/8" Casing @ 2780 with 300 sacks

STATE OF OKLAHOMA )  
CITY OF TULSA )

RECEIVED  
STATE COURT  
FEB 27 1952  
CO. MEADE  
Wichita, Kansas  
DIVISION

I hereby affirm that the above and foregoing is a true and correct copy of the log of our H. G. Adams "A" Well No. 2, located in the Center of the Southwest Quarter in the Southeast Quarter in Section 31, Township 33 South, Range 29 West, Meade County, Kansas.

WHITE EAGLE OIL COMPANY

*W. H. Adams*  
Vice-President

PLUGGING  
FILE SEC 31 T 33 R 29 W

Subscribed and sworn to before me as Notary Public, this 29th day of January, 1952.

*W. H. Adams*  
Notary Public

My Commission expires March 13, 1954.