


15-129-10466-0000

STATE OF KANSAS
STATE CORPORATION COMMISSION

Give All Information Completely
Make Required Affidavit
Mail or Deliver Report to:
Conservation Division
State Corporation Commission
211 No. Broadway
Wichita, Kansas

WELL PLUGGING RECORD

NORTH

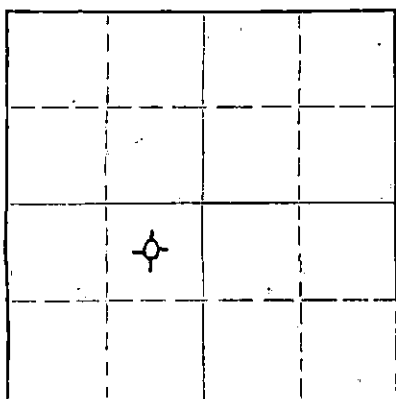

Locate well correctly on above
Section Plat

Morton County. Sec. 36 Twp. 34S Rge. 42 (W)
Location as "NE/CNW/SW" or footage from lines G NE/1 SW/1
Lease Owner Panhandle Eastern Pipe Line Company
Lease Name Bennett "B" Well No. 04
Office Address Box #979, Liberal, Kansas
Character of Well (completed as Oil, Gas or Dry Hole) Dry Hole
Date well completed February 28, 19 57
Application for plugging filed February 28, 19 57
Application for plugging approved Verbal approval by M.A. Rives 2/28/57
Plugging commenced February 28, 19 57
Plugging completed February 28, 19 57
Reason for abandonment of well or producing formation Dry Hole

If a producing well is abandoned, date of last production - - - 19 -
Was permission obtained from the Conservation Division or its agents before plugging was commenced? Verbal Approval obtained from M. A. Rives - 2/28/57

Name of Conservation Agent who supervised plugging of this well M. A. RivesProducing formation None Depth to top. - Bottom - Total Depth of Well 5132 Feet

Show depth and thickness of all water, oil and gas formations.

OIL, GAS OR WATER RECORDS

CASING RECORD

FORMATION	CONTENT	FROM	TO	SIZE	PUT IN	PULLED OUT
U. Morrow Sand	Dry	4652'	4952'	8-5/8"	4495'	0
Keyes Sand	Salt Water	5014'	5103'			
Mississippian	Dry	5103'	5132'			

Describe in detail the manner in which the well was plugged, indicating where the mud fluid was placed and the method or methods used in introducing it into the hole. If cement or other plugs were used, state the character of same and depth placed, from - feet to - feet for each plug set.

Filled hole with heavy mud from bottom to 4573'. Placed a twenty-five sack cement plug from 4573' to 4500'. Filled hole to 650' with heavy mud. Placed a thirty-five sack cement plug from 650' to 550'. Filled hole with mud to 35'. Placed a Halliburton plug at 35' and cut casing off six feet below surface. Filled hole from 35' to top of casing with cement.

(If additional description is necessary, use BACK of this sheet)

Name of Plugging Contractor A plugging Contractor was not used. Halliburton cemented this well.
Address -

STATE OF Kansas, COUNTY OF Seward, ss.
L. W. Phillips (employee of owner) or (~~owner or operator~~) of the above-described

well, being first duly sworn on oath, says: That I have knowledge of the facts, statements, and matters herein contained and the log of the above-described well as filed and that the same are true and correct. So help me God.

(Signature) L. W. Phillips

Box #979, Liberal, Kansas
(Address)

SUBSCRIBED AND SWORN to before me this 7th day of February, 19 57

MY COMMISSION EXPIRES

My commission expires NOVEMBER 23, 1959

Raymond R. Roper
STATE CORPORATION COMMISSIONER Public.

PLUGGING

FILE SEC. 36 T. 34 R. 42W
BOOK PAGE 145 LINE 11

MAR 10 1957
3-12-1957
CONSERVATION DIVISION
Wichita, Kansas

DRILLER'S LOG

WELL NAME: Bennett "B"-#04
 WELL LOCATION: 1980' East of West Line and 1980' North of South Line of Section 36,
 Township 34S, Range 42W,
 COUNTY: Morton STATE: Kansas ELEVATION: 3501.11'
 COMPANY: Panhandle Eastern Pipe Line Company, Box #979, Liberal, Kansas
 CONTRACTOR: Nye and Snell Drilling Company, 260 Denver Club Bldg, Denver, Colo.
 DRILLING COMMENCED: February 6, 1957 OPEN FLOW: Dry Hole
 DRILLING COMPLETED: February 27, 1957
 WELL COMPLETED: February 28, 1957 OPEN FLOW, After Acid:
 WELL CONNECTED: Dry Hole Rock Pressure:
 SOURCE OF DATA: Driller's Report

ROTARY LOG

Description of Formation	Top	Bottom
Shale, Sand & Red Bed	0'	460'
Shale & Red Bed	460'	872'
Lime and Shale	872'	1500'
(Set 1495' of 8-5/8" Surface Casing w/825 sacks common cement)		
Lime and Shale	1500'	4713'
Lime, Shale & Sand	4713'	4863'
Lime and Shale	4863'	5132' TD.

FORMATIONS	Tops
Waubaunsee	2805'
Topeka	3018'
Greenwood Lansing	3285'
Lansing	3512'
Cherokee	4244'
Morrow Shale	4549'
U. Morrow Sand	4652' & 4666'

PERFORATIONS

Ran 4 Drill Stem Tests with no show
 of gas or oil. Well was not perforated.

RECEIVED
 STATE CORPORATION COMMISSION

WELL TREATMENT RECORD Morrow "G" Sand - 4952'; L. Morrow Sand - 4973'; Keyes Sand - 5014';
 Mississippi - 5103'.
 This Well was a dry hole. Well was not treated.

CONSERVATION DIVISION
 Wichita, Kansas

PLUGGING

FILE SEC 36 T 34 R 42W
 BOOK PAGE 145 LINE 11