

CORRECTED ACO-1*

SIDE ONE

STATE CORPORATION COMMISSION OF KANSAS
OIL & GAS CONSERVATION DIVISION

WELL COMPLETION OR RECOMPLETION FORM
ACO-1 WELL HISTORY

DESCRIPTION OF WELL AND LEASE

Operator: license # 5238
name Petroleum Inc.
address Liberal Kansas 67901
City/State/Zip

Operator Contact Person Steve Phillips
Phone 316-624-1686

Contractor: license # 5879
name Bohannon Drilling

Wellsite Geologist James Nichols
Phone 316-624-2623

PURCHASER Jayhawk Pipeline

Designate Type of Completion
 New Well Re-Entry Workover

Oil SWD Temp Abd
 Gas Inj Delayed Comp.
 Dry Other (Core, Water Supply etc.)

OWWO: old well info as follows:
Operator
Well Name
Comp. Date Old Total Depth

WELL HISTORY

Drilling Method: Mud Rotary Air Rotary Cable
3/31/84 4/11/84 4/25/84
Spud Date Date Reached TD Completion Date

6600 6553
Total Depth PBD

Amount of Surface Pipe Set and Cemented at 1683.21 feet

Multiple Stage Cementing Collar Used? Yes No

If Yes, Show Depth Set feet

Alternate 2 completion, cement circulated
from feet depth to w/ SX cmt

API NO. 15-175-20,749-00-00

County Seward

NE NE NW Sec 30 Twp 34S Rge 34 East
(location) XXWest


4726 Ft North from Southeast Corner of Section
4514 Ft West from Southeast Corner of Section
(Note: locate well in section plat below)

Lease Name Mueller "D" Well# 3

*Field Name R. G. Field

Producing Formation Lower Chester

Elevation: Ground 2959 KB 2971

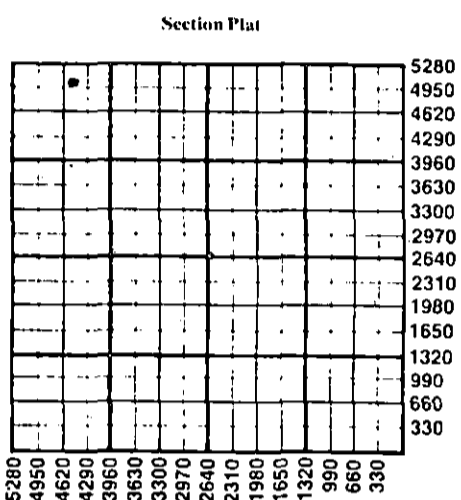

WATER SUPPLY INFORMATION

Source of Water:
Division of Water Resources Permit # T83-619

Groundwater approx 1940 Ft North From Southeast Corner and
(Well) 540 Ft. West From Southeast Corner of
Sec 30 Twp 34S Rge 34 XXEast XXWest

Surface Water Ft North From Southeast Corner and
(Stream, Pond etc.) Ft West From Southeast Corner
Sec Twp Rge East West

Other (explain)
(purchased from city, R.W.D.#)

Disposition of Produced Water: Disposal Repressuring

Docket #

INSTRUCTIONS: This form shall be completed in duplicate and filed with the Kansas Corporation Commission, 200 Colorado Derby Building, Wichita, Kansas 67202, within 90 days after completion or recompletion of any well. Rules 82-3-130 and 82-3-107 apply.

Information on side two of this form will be held confidential for a period of 12 months if requested in writing and submitted with the form. See rule 82-3-107 for confidentiality in excess of 12 months.

One copy of all wireline logs and drillers time log shall be attached with this form. Submit CP-4 form with all plugged wells. Submit CP-111 form with all temporarily abandoned wells.

All requirements of the statutes, rules, and regulations promulgated to regulate the oil and gas industry have been fully complied with and the statements herein are complete and correct to the best of my knowledge.

RECEIVED
STATE CORPORATION COMMISSION

Signature Steven L. Phillips
Title Dist. Prod. Supt. Date

JUL 30 1984
CONSERVATION DIVISION
Wichita, Kansas

Subscribed and sworn to before me this 27th day of July 1984

Notary Public James R. Hatfield
Date Commission Expires

NOTARY PUBLIC - State of Kansas
JAMES R. HATFIELD
My Appt. Exp. 9/25/86

K.C.C. OFFICE USE ONLY
 Letter of Confidentiality Attached
 Wireline Log Received
 Drillers Timelog Received
Distribution
 KEC SWD/Rep NGPA
 KGS Plug Other
(Specify)

Form ACO-1 (7-84)

Sec 30 Twp 34 Rge 34