

STATE OF KANSAS  
STATE CORPORATION COMMISSION


WELL PLUGGING RECORD

Give All Information Completely  
Make Required Affidavit  
Mail or Deliver Report to:  
Conservation Division  
State Corporation Commission  
212 North Market, Insurance Bldg.  
Wichita, Kansas

Meade County, Sec. 7 Twp. 33S Rge. 29 (X) X (W)

Location as "NE/CNW/SW" or footage from lines 660' from North and East  
Lease Owner The Shamrock Oil and Gas Corporation  
Lease Name Rhees R. Singley Well No. 1  
Office Address Box 631, Amarillo, Texas  
Character of Well (completed as Oil, Gas or Dry Hole) Dry Hole  
Date well completed May 4, 19 59  
Application for plugging filed May 4, 19 59  
Application for plugging approved May 4, 19 59  
Plugging commenced May 4, 19 59  
Plugging completed May 4, 19 59  
Reason for abandonment of well or producing formation Dry

NORTH

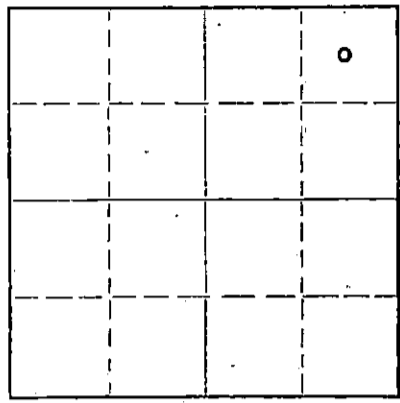

Locate well correctly on above Section Plat

If a producing well is abandoned, date of last production -- 19  
Was permission obtained from the Conservation Division or its agents before plugging was commenced? Yes

Name of Conservation Agent who supervised plugging of this well Merle Rives  
Producing formation \_\_\_\_\_ Depth to top \_\_\_\_\_ Bottom \_\_\_\_\_ Total Depth of Well 5,932 Feet  
Show depth and thickness of all water, oil and gas formations.

OIL, GAS OR WATER RECORDS

CASING RECORD

FORMATION	CONTENT	FROM	TO	SIZE	PUT IN	PULLED OUT
Sand and shale	Pos. water	340	520	9 5/8"	1,552	-0-

Describe in detail the manner in which the well was plugged, indicating where the mud fluid was placed and the method or methods used in introducing it into the hole. If cement or other plugs were used, state the character of same and depth placed, from \_\_\_\_\_ feet to \_\_\_\_\_ feet for each plug set.  
Filled hole with mud to 600'. Pushed 9 5/8" Halliburton plug to 600'. Spotted 35 sacks cement at 600'. Filled hole with mud. Pushed plug to 35' below surface. Cemented bottom of cellar with 5 sacks.

RECEIVED  
STATE CORPORATION COMMISSION  
MAY 7 1959  
CONSERVATION DIVISION  
Wichita, Kansas

(If additional description is necessary, use BACK of this sheet)

Name of Plugging Contractor Halliburton Oil Well Cementing Company  
Address Great Bend, Kansas

STATE OF Texas COUNTY OF Potter, ss.  
T. S. Clopton (employee of owner) or (owner) of the above-described well, being first duly sworn on oath, says: That I have knowledge of the facts, statements, and matters herein contained and the log of the above-described well as filed and that the same are true and correct. So help me God.

(Signature) T. S. Clopton  
Box 631, Amarillo, Texas (Address)

SUBSCRIBED AND SWORN to before me this 6th day of May, 19 59  
My commission expires 6-1-59  
Notary Public.

PLUGGING  
FILE SEC. 7 T. 33 R. 29  
BOOK PAGE 36 LINE 20

RHEES R. SINGLEY NO. 1  
(Section 7, Twp. 33S, Rge. 29 W)  
Meade County, Kansas

0'	-	340'	Sand, shale, & shells
340'	-	520'	Sand & shale
520'	-	740'	Red bed & shells
740'	-	850'	Red bed, sand, & shells
850'	-	2,066'	Shale & shells
2,066'	-	2,340'	Shale, lime, & shells
2,340'	-	2,500'	Shale & shells
2,500'	-	4,697'	Shale & lime
4,697'	-	4,730'	Lime
4,730'	-	4,825'	Lime & shale
4,825'	-	5,026'	Lime
5,026'	-	5,090'	Lime & shale
5,090'	-	5,160'	Lime
5,160'	-	5,170'	Shale
5,170'	-	5,345'	Lime
5,345'	-	5,350'	Shale
5,350'	-	5,744'	Lime
5,744'	-	5,932'	Lime & shale

RECEIVED  
STATE CORPORATION COMMISSION  
MAY 7 1959  
CONSERVATION DIVISION  
Wichita, Kansas

PLUGGING  
FILE SEC 7 T 33 R 27  
BOOK PAGE 36 LINE 22