


Give All Information Completely  
Make Required Affidavit  
Mail or Deliver Report to:  
Conservation Division  
State Corporation Commission  
211 No. Broadway  
Wichita, Kansas

WELL PLUGGING RECORD

Meade County, Sec. 8 Twp 33S Rge. 29 (E) W(W)

Location as "NE/CNW/SW" or footage from lines SW $\frac{1}{4}$  NE $\frac{1}{4}$   
Lease Owner Ferguson Oil Co.  
Lease Name Cottrell Well No. 1 - 8B  
Office Address Suite 522 Union Center, Wichita, Kansas  
Character of Well (completed as Oil, Gas or Dry Hole) Dry Hole  
Date well completed Aug. 30 19 63  
Application for plugging filed Aug. 30 19 63  
Application for plugging approved Aug. 30 19 63  
Plugging commenced Aug. 30 19 63  
Plugging completed Aug. 30 19 63  
Reason for abandonment of well or producing formation

NORTH

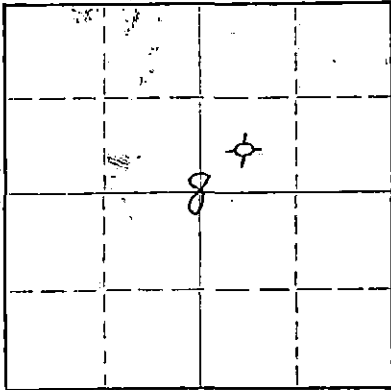

Locate well correctly on above  
Section Plat

If a producing well is abandoned, date of last production 19  
Was permission obtained from the Conservation Division or its agents before plugging was commenced? Yes

Name of Conservation Agent who supervised plugging of this well Hugh B. Scott, Sublette, Kansas  
Producing formation Depth to top Bottom Total Depth of Well 5860 Feet  
Show depth and thickness of all water, oil and gas formations.

OIL, GAS OR WATER RECORDS

CASING RECORD

FORMATION	CONTENT	FROM	TO	SIZE	PUT IN	PULLED OUT
		0	1458'	8-5/8	1458'	-0-

Describe in detail the manner in which the well was plugged, indicating where the mud fluid was placed and the method or methods used in introducing it into the hole. If cement or other plugs were used, state the character of same and depth placed, from feet to feet for each plug set.

Ran Howco plug to 760', cement with 35 sx Common, mud to 40', plug with 15 sx Common to bottom of cellar.

RECEIVED  
STATE CORPORATION COMMISSION

SEP 10 1963

CONSERVATION DIVISION  
Wichita, Kansas

(If additional description is necessary, use BACK of this sheet)

Name of Plugging Contractor The R. W. Rine Drilling Company  
Address 420 Union Center, Wichita 2, Kansas

STATE OF Kansas, COUNTY OF Sedgwick, ss.  
R. M. Green (employee of owner) of (owner or operator) of the above-described well, being first duly sworn on oath, says: That I have knowledge of the facts, statements, and matters herein contained and the log of the above-described well as filed and that the same are true and correct. So help me God.

(Signature) R. M. Green  
420 Union Center, Wichita, Kansas  
(Address)

SUBSCRIBED AND SWORN TO before me this 9th day of September, 1963

My commission expires 8-6-67

Janet C. McLaughlin  
Notary Public.

SW NE  
 Sec. 8-33S-29W  
 Meade County, Kansas

COTTRELL WELL NO. 1-8B,

CONTRACTOR: The R. W. Rine Drilling Company

STARTED: August 16, 1963

COMPLETED: August 30, 1963

	L O G	
	0'	314'
Sand, Shells	0'	314'
Red Bed, Sand	314'	900'
Red Bed, Sand	900'	1459'
Anhydrite		
Anhydrite, Shale	1459'	2019'
Sand, Shale, Anhydrite	2019'	2473'
Shale w/ lime streaks	2473'	2731'
Lime, Shale	2731'	3308'
Lime, Shale, Chalk Stringers	3308'	3451'
Lime, Shale	3451'	3865'
Shale	3865'	4135'
Shale, Lime	4135'	4238'
Shale	4238'	4513'
Shale, Lime	4513'	4883'
Lime	4883'	4998'
Lime, Shale	4998'	5098'
Lime	5098'	5434'
Lime, Shale	5434'	5494'
Lime	5494'	5658'
Lime, Shale	5658'	5727'
Lime, Sand	5727'	5745'
Lime	5745'	5860'

Totco @ 200', 1/2°  
 Totco @ 609', 3/4°  
 Totco @ 1240', 1/2°, @ 1459', 3/4°  
 8 5/8" Csg. @ 1458' w/ 400 Sx.  
 light weight w/ 250 sx. common  
 w/ 3% IAS

Totco @ 2402', 1°  
 Totco @ 2731', 1/2°

Totco @ 3450', 3/4°

**RECEIVED**  
 STATE CORPORATION COMMISSION

SEP 10 1963

CONSERVATION DIVISION  
 Wichita, Kansas

Totco @ 5300', 1°

T. D.: Howco plug to 760'  
 cement w/ 35/sx, Mud to 40',  
 plug w/ 15 sx.

STATE OF KANSAS )  
 COUNTY OF SEDGWICK ) ss

I, R. M. Green, do hereby certify that the above is a true and accurate log of the Cottrell Well No. 1-8B, located SW NE of Section 8-33S-29W, Meade County, Kansas.

*R M Green*  
 Secretary-Treasurer

Subscribed and sworn to before me this 6th day of September, 1963.

*John E. [Signature]*  
 Notary Public

My Commission Expires: 6/14/66