


15-119-30007-0000

Give All Information Completely
Make Required Affidavit
Mail or Deliver Report to:
Conservation Division
State Corporation Commission
211 No. Broadway
Wichita, Kansas

WELL PLUGGING RECORD

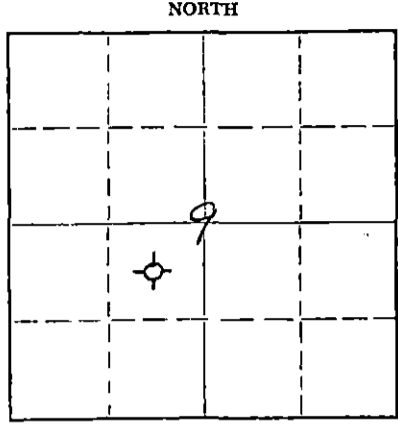

Locate well correctly on above Section Plat

MEADE County. Sec. 9 Twp. 33-S Rge. (E) 29 (W)
Location as "NE/CNW%SW%" or footage from lines C NE SW
Lease Owner FERGUSON OIL COMPANY
Lease Name COTTRELL Well No. 1-9
Office Address 522 UNION CENTER, WICHITA, KANSAS
Character of Well (completed as Oil, Gas or Dry Hole) DRY HOLE
Date well completed 3/7 1965
Application for plugging filed 3/7 1965
Application for plugging approved 3/7 1965
Plugging commenced 3/7 1965
Plugging completed 3/7 1965
Reason for abandonment of well or producing formation

If a producing well is abandoned, date of last production NONE 19
Was permission obtained from the Conservation Division or its agents before plugging was commenced? YES

Name of Conservation Agent who supervised plugging of this well HUGH SCOTT, SUBLETTE, KANSAS
Producing formation Depth to top Bottom Total Depth of Well 5860 Feet
Show depth and thickness of all water, oil and gas formations.

OIL, GAS OR WATER RECORDS

CASING RECORD

FORMATION	CONTENT	FROM	TO	SIZE	PUT IN	PULLED OUT
		0	1478	8 5/8"	1478	-0-

Describe in detail the manner in which the well was plugged, indicating where the mud fluid was placed and the method or methods used in introducing it into the hole. If cement or other plugs were used, state the character of same and depth placed, from feet to feet for each plug set.

Heavy drilling mud from total depth of 5860' to 700'. Spotted 35 sx. cement through open end drill pipe @ 700'. Spotted 15 sx. at 40' to bottom of cellar.

RECEIVED
STATE CORPORATION COMMISSION

MAR 11 1965

CONSERVATION DIVISION
Wichita, Kansas

(If additional description is necessary, use BACK of this sheet)
Name of Plugging Contractor THE R. W. RINE DRILLING COMPANY
Address 420 UNION CENTER, WICHITA, KANSAS

STATE OF KANSAS, COUNTY OF SEDGWICK
R. M. Green, contractor, ss.
(employee of owner or operator) of the above-described well, being first duly sworn on oath, says: That I have knowledge of the facts, statements, and matters herein contained and the log of the above-described well as filed and that the same are true and correct. So help me God.

(Signature) R. M. Green
420 UNION CENTER, WICHITA, KANSAS
(Address)

SUBSCRIBED AND SWORN TO before me this 10th day of March, 1965

Myrna Thompson
Myrna Thompson Notary Public.

My commission expires March 18, 1968

C NE SW
SECTION 9-33S-29W
MEADE COUNTY, KANSAS

COTTRELL WELL NO. 1-9

CONTRACTORS: THE R. W. RINE DRILLING COMPANY

STARTED: FEBRUARY 22, 1965

COMPLETED: MARCH 8, 1965

L O G

Sand	0' - 316'
Sand & Red Bed	316' - 816'
Shale	816' - 1405'
Anhydrite	1405' - 1479'
Anhydrite & Shale	1479' - 1905'
Shale	1905' - 2401'
Shale & Lime	2401' - 2685'
Lime	2685' - 3175'
Lime & Sand Stringers	3175' - 3430'
Lime	3430' - 3786'
Lime & Shale	3786' - 4065'
Shale	4065' - 4230'
Lime & Shale	4230' - 4660'
Lime	4660' - 4842'
Lime, Sand, Shale	4842' - 4972'
Lime	4972' - 5168'
Lime, Shale Streaks	5168' - 5272'
Lime	5272' - 5520'
Lime, Shale Streaks	5520' - 5595'
Lime	5595' - 5660'
Lime & Sand	5660' - 5700'
Lime & Shale	5700' - 5745'
Lime, Shale, Sand	5745' - 5805'
Lime	5805' - 5860'

Totco @ 500', 1/2"
Totco @ 1000', 1/2"
Totco @ 1475', 3/4"; 8 5/8" @ 1478'
w/800 sx. poz.

Totco @ 2780', 1"

Totco @ 3430', 1 1/2"

Totco @ 4160',

RECEIVED
STATE CORPORATION COMMISSION

MAR 11 1965

CONSERVATION DIVISION
Wichita, Kansas


D & A 35 sx. @ 700' & 15 sx. @ top
8 5/8".

STATE OF KANSAS)
COUNTY OF SEDGWICK) ss

I, R. M. Green, do hereby certify that the above is a true and accurate log of the Cottrell Well No. 1-9, located C of NE of SW of Section 9-33S-29W, Meade County, Kansas.


R. M. Green, Secretary-Treasurer

Subscribed and sworn to before me this 10th day of March, 1965.

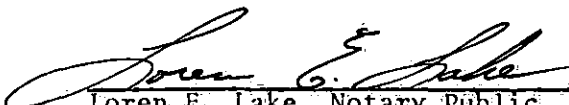
Loren E. Lake, Notary Public

My Commission Expires: 6/14/66