

STATE OF KANSAS
STATE CORPORATION COMMISSION

WELL PLUGGING RECORD

Give All Information Completely
Make Required Affidavit
Mail or Deliver Report to:
Conservation Division
State Corporation Commission
212 North Market, Insurance Bldg.
Wichita, Kansas

Seward County, Sec. 25 Twp. 33S Rge. 31 (EX (W)

Location as "NE/CNW/SW" or footage from lines 660' fr. South & 1980' Fr. West

Lease Owner The Shamrock Oil and Gas Corporation

Lease Name Robert A. Simonson Well No. 2

Office Address Box 631, Amarillo, Texas

Character of Well (completed as Oil, Gas or Dry Hole) Dry Hole

Date well completed 9-22 19 60

Application for plugging filed 9-22 19 60

Application for plugging approved 9-22 19 60


Plugging commenced 9-23 19 60

Plugging completed 9-23 19 60

Reason for abandonment of well or producing formation Dry

If a producing well is abandoned, date of last production None 19

Was permission obtained from the Conservation Division or its agents before plugging was commenced? Yes

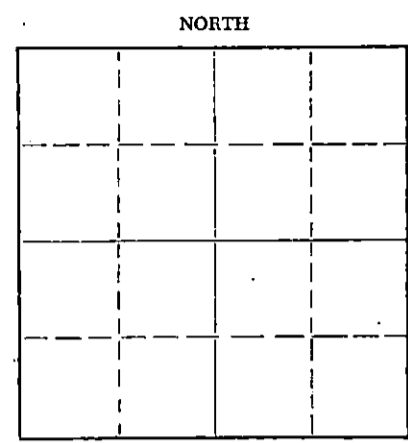

Name of Conservation Agent who supervised plugging of this well Mr. W. L. Lackamp, Jr., State Engineer
Producing formation None Depth to top Bottom Total Depth of Well 6,275 Feet
Show depth and thickness of all water, oil and gas formations.

OIL, GAS OR WATER RECORDS				CASING RECORD		
FORMATION	CONTENT	FROM	TO	SIZE	PUT IN	PULLED OUT
None				9 5/8"	1,512	--0--

Describe in detail the manner in which the well was plugged, indicating where the mud fluid was placed and the method or methods used in introducing it into the hole. If cement or other plugs were used, state the character of same and depth placed, from feet to feet for each plug set.

Filled hole to 1,500' and pushed Halliburton plug to 1,500'. Spotted 25 sacks cement on plug. Filled hole with mud to 600'. Pushed plug to 600' and spotted 30 sacks cement. Filled hole to 45' and pushed plug to 45'. Spotted 15 sacks cement to surface.

RECEIVED
STATE CORPORATION COMMISSION
SEP 28 1960
CONSERVATION DIVISION
Wichita, Kansas

(If additional description is necessary, use BACK of this sheet)
Name of Plugging Contractor Halliburton Oil Well Cementing Company
Address Liberal, Kansas

STATE OF Texas, COUNTY OF Potter, ss.
T. S. Clopton (employee of owner) or (owner/operator) of the above-described well, being first duly sworn on oath, says: That I have knowledge of the facts, statements, and matters herein contained and the log of the above-described well as filed and that the same are true and correct. So help me God.

(Signature) T. S. Clopton
Box 631, Amarillo, Texas (Address)

SUBSCRIBED AND SWORN to before me this 27th day of September, 19 60
Pauline Powell, Notary Public
Potter County, Texas

My commission expires 6-1-60

15-175-10109-0000

ROBERT A. SIMONSON NO. 2
Section 25, Township 33 South, Range 31 West
Seward County, Kansas

0' - 713'	Sand, shale, and shells
713' - 1,350'	Shale and shells
1,350' - 1,516'	Shale, gyp, and shale
1,516' - 1,965'	Sand, shale, and shells
1,965' - 2,175'	Shale and shells
2,175' - 4,626'	Shale and lime
4,626' - 4,681'	Lime
4,681' - 4,720'	Lime and shale
4,720' - 4,882'	Lime
4,882' - 5,153'	Lime and shale
5,153' - 5,202'	Lime
5,202' - 5,279'	Lime and shale
5,279' - 5,420'	Shale
5,420' - 5,450'	Lime
5,450' - 5,500'	Shale
5,500' - 5,830'	Lime and shale
5,830' - 5,950'	Sand and lime
5,950' - 6,275'	Lime

J. S. Clayton

RECEIVED
STATE CORPORATION COMMISSION

SEP 28 1960

CONSERVATION DIVISION
Kansas