

Give All Information Completely  
Make Required Affidavit  
Mail or Deliver Report to:  
Conservation Division  
State Corporation Commission  
211 No. Broadway  
Wichita, Kansas

WELL PLUGGING RECORD

Meade County, Sec. 10 Twp. 33S Rge. 29W (E) (W)

Location as "NE/CNW/SW" or footage from lines C - E/2 NE/4

Lease Owner Mallonee & Mahoney, Inc.

Lease Name Berghaus #1 Well No. 1

Office Address P. O. Box 1257, Liberal, Kansas 67901

Character of Well (completed as Oil, Gas or Dry Hole) Dry Hole

Date well completed 7-26 19 68

Application for plugging filed 8-12 19 68

Application for plugging approved 8-13 19 68


Plugging commenced August 12 19 68

Plugging completed August 26 19 68

Reason for abandonment of well or producing formation Dry Hole

If a producing well is abandoned, date of last production 19

Was permission obtained from the Conservation Division or its agents before plugging was commenced? Yes

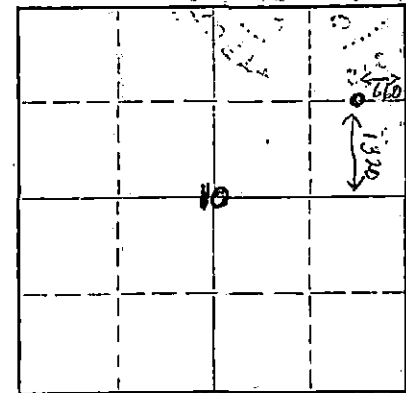

Locate well correctly on above Section Plat

Name of Conservation Agent who supervised plugging of this well E. Eves

Producing formation Depth to top Bottom Total Depth of Well 5705 PB Feet

Show depth and thickness of all water, oil and gas formations.

OIL, GAS OR WATER RECORDS

CASING RECORD

FORMATION	CONTENT	FROM	TO	SIZE	PUT IN	PULLED OUT

Describe in detail the manner in which the well was plugged, indicating where the mud fluid was placed and the method or methods used in introducing it into the hole. If cement or other plugs were used, state the character of same and depth placed, from feet to feet for each plug set.

Mix 20 sks. to plug off perfs. Stop plug at 5,122'.  
Pump 35 sks. cement at 800' and displace with gell.

RECEIVED  
STATE CORPORATION COMMISSION  
SEP 5 1968  
CONSERVATION DIVISION  
Wichita, Kansas

(If additional description is necessary, use BACK of this sheet)  
Name of Plugging Contractor Sargents Casing Pulling Service  
Address Liberal, Kansas

STATE OF Kansas, COUNTY OF Seward, ss.  
I, William F. Dean (employee of owner) or (owner or operator) of the above-described

well, being first duly sworn on oath, says: That I have knowledge of the facts, statements, and matters herein contained and the log of the above-described well as filed and that the same are true and correct. So help me God.

(Signature) William F. Dean

Box 1257, Liberal, Kansas (Address)

SUBSCRIBED AND SWORN TO before me this 4th day of September, 19 68

Joene Dorsett Notary Public.

My commission expires January 31, 1971

