


Give All Information Completely
Make Required Affidavit
Mail or Deliver Report to:
Conservation Division
State Corporation Commission
211 No. Broadway
Wichita, Kansas

WELL PLUGGING RECORD

Meade County, Sec. 10 Twp. 33 S Rge. (E) 29 (W)

Location as "NE/CNW/SW" or footage from lines
Lease Owner Edwin G. Bradley
Lease Name Berghaus Well No. 1
Office Address 826 Union Center - Wichita, Kansas 67202
Character of Well (completed as Oil, Gas or Dry Hole) Dry Hole
Date well completed October 16 19 67
Application for plugging filed October 16 19 67
Application for plugging approved October 16 19 67
Plugging commenced 4:00 p.m. October 16 19 67
Plugging completed 6:00 p.m. October 16 19 67
Reason for abandonment of well or producing formation Dry and Abandoned

If a producing well is abandoned, date of last production _____ 19 ____
Was permission obtained from the Conservation Division or its agents before plugging was commenced? Yes

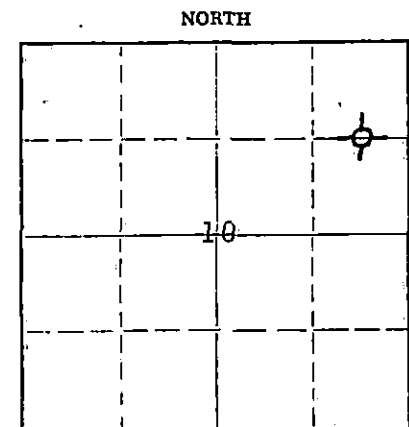

Locate well correctly on above Section Plat

Name of Conservation Agent who supervised plugging of this well Ed Eads, Sublette, Kansas
Producing formation _____ Depth to top _____ Bottom _____ Total Depth of Well _____ Feet
Show depth and thickness of all water, oil and gas formations.

OIL, GAS OR WATER RECORDS

CASING RECORD

FORMATION	CONTENT	FROM	TO	SIZE	PUT IN	PULLED OUT
				8-5/8"	1384'	-0-

Describe in detail the manner in which the well was plugged, indicating where the mud fluid was placed and the method or methods used in introducing it into the hole. If cement or other plugs were used, state the character of same and depth placed, from _____ feet to _____ feet for each plug set.

Ran in with open end drill pipe and spotted 35 sx. cement from 700' to 600' and 15 sx. from 45' to bottom of celler

RECEIVED
STATE CORPORATION COMMISSION
OCT 26 1967

CONSERVATION DIVISION
Wichita, Kansas

(If additional description is necessary, use BACK of this sheet)
Name of Plugging Contractor Rine Drilling Company, Inc.
Address Suite 600 - 300 West Douglas - Wichita, Kansas 67202

STATE OF Kansas COUNTY OF Sedgewick, ss.
Geo. R. Shaw (employee of owner) or (owner or operator) of the above-described well, being first duly sworn on oath, says: That I have knowledge of the facts, statements, and matters herein contained and the log of the above-described well as filed and that the same are true and correct. So help me God.

(Signature) Geo. R. Shaw
826 Union Center, Wichita, Ks
(Address)

SUBSCRIBED AND SWORN TO before me this 25th day of October, 1967

My commission expires July 24, 1971
Ginny Ayden Notary Public.

C E/2 NE
SECTION 10-33S-29W
MEADE COUNTY, KANSAS

BERGHAUS WELL NO. 1

CONTRACTOR: RINE DRILLING COMPANY, INC.

STARTED: OCTOBER 4, 1967

COMPLETED: OCTOBER 17, 1967

L O G

Sand and Gravel	0'	-	183'
Red Bed, Gypsum & Sand	183'	-	1040'
Red Bed	1040'	-	1876'
Red Bed, Anhy. Strgs.	1876'	-	2655'
Anhydrite	2655'	-	2867'
Lime Streaks	2867'	-	3035'
Lime & Shale	3035'	-	3508'
Lime Streaks	3508'	-	3554'
Lime & Shale	3554'	-	3885'
Shale & Lime Streaks	3885'	-	4070'
Lime & Shale	4070'	-	4750'
Lime	4750'	-	4929'
Lime Streaks	4929'	-	5022'
Lime & Shale	5022'	-	5160'
Lime Streaks	5160'	-	5305'
Lime & Shale	5305'	-	5341'
Lime	5341'	-	5420'
Lime Streaks	5420'	-	5480'
Lime & Shale	5480'	-	5577'
Lime	5577'	-	5610'
Lime Streaks	5610'	-	5708'
Lime	5708'	-	5713'
Lime Streaks	5713'	-	5738'

Totco - 3/4° @ 1390'
Ran 35 jts. 8 5/8" csg. to 1384'
w/550 sx. Poz mis 2% gel, 2% CC
Followed w/200 common 2% CC

Totco - 3/4° @ 4067' **RECEIVED**
STATE CORPORATION COMMISSION
OCT 26 1967

Totco 1 1/4° @ 5479' CONSERVATION DIVISION
Wichita, Kansas

Totco 3/4° @ 5728'
Laid down D.P. & plugged @ 700' & 60'

STATE OF KANSAS)
) SS.
COUNTY OF SEDGWICK)

I, R. M. Green, do hereby certify that the above is a true and accurate log of the Berghaus Well No. 1, located D of E/2 of NE of Section 10-33S-29W, Meade County, Kansas.

R. M. Green
R. M. Green, Secretary-Treasurer

Subscribed and sworn to before me this 20th day of October, 1967.

My Commission Expires: 6/14/70

Loren E. Lake
Loren E. Lake, Notary Public