


Give All Information Completely
Make Required Affidavit
Mail or Deliver - Report to:
Conservation Division
State Corporation Commission
P. O. Box 17027
Wichita, Kansas 67217
NORTH

WELL PLUGGING RECORD

Location as "NE/CNW/SW" or footage from lines Meade County. Sec. 11 Twp. 33S Rge. 29 (E) (W) X
Lease Owner William R. Braley, et al.
Lease Name Berghaus Well No. 1
Office Address P.O. Box 768, Woodward, Oklahoma 73801
Character of Well (completed as Oil, Gas or Dry Hole) Oil
Date well completed unknown 19
Application for plugging filed 12-3 19 73
Application for plugging approved 12-6 19 73
Plugging commenced 1-1 19 74
Plugging completed 1-9 19 74
Reason for abandonment of well or producing formation Mechanical
If a producing well is abandoned, date of last production April 19 73
Was permission obtained from the Conservation Division or its agents before plugging was commenced? Yes

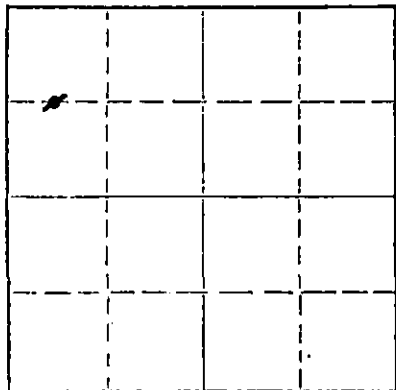

Locate well correctly on above Section Flat

Name of Conservation Agent who supervised plugging of this well Ed Eyes
Producing formation MORROW Depth to top 5674 Bottom 5706 Total Depth of Well 5750 Feet
Show depth and thickness of all water, oil and gas formations.

OIL, GAS OR WATER RECORDS

CASING RECORD

FORMATION	CONTENT	FROM	TO	SIZE	PUT IN	PULLED OUT
				8 5/8	1528	none
				5 1/2	5749	2728

Describe in detail the manner in which the well was plugged, indicating where the mud fluid was placed and the method or methods used in introducing it into the hole. If cement or other plugs were used, state the character of same and depth placed, from feet to feet for each plug set.

20 sks. of cement @ 5600
35 sks. of cement @ 1000 to 900
15 sks. of cement @ 45 to 0

RECEIVED
STATE CORPORATION COMMISSION
JAN 28 1974
CONSERVATION DIVISION
Wichita, Kansas

(If additional description is necessary, use BACK of this sheet)
Name of Plugging Contractor Sargents Casing Pulling Service Kansas No. 511
Address Box 506 Liberal, Kansas 67901

STATE OF Oklahoma, COUNTY OF Woodward, ss.
William R. Braley (employee of owner) or operator of the above-described well, being first duly sworn on oath, says: That I have knowledge of the facts, statements, and matters herein contained and the log of the above-described well as filed and that the same are true and correct. So help me Gpd.

(Signature) William R. Braley
P.O. Box 768, Woodward, Oklahoma 73801
(Address)

SUBSCRIBED AND SWORN TO before me this 25 day of January, 19 74

My commission expires July 27 1977
M. L. Blackley Notary Public.


15-191-10135-0000

Company. PETROLEUM MANAGEMENT
 Farm. Berghaus No. 1

SEC. 11 T. 33 R. 29W
 C W 1/2 NW

Total Depth. 5750'
 Comm. 12-6-62 Comp. 12-22-62
 Shot or Treated.
 Contractor. R. W. Rine Drlg.
 Issued. 6-26-65

County Meade
 KANSAS

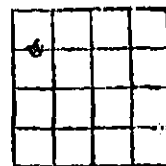

Elevation. 2597' RB

Production. 135 BOPD

CASING:

8 5/8" 1528' cem w/ 650 sx
 5 1/2" 5749' cem w/ 125 sx

Figures Indicate Bottom of Formations.

sand & red bed.	500
red bed, shale & anhydrite	1435
red bed & anhydrite	1820
salt & anhydrite	2608
anhydrite	2718
shale & lime	2891
lime	3120
shale & lime	3735
shale	3939
shale & lime	4089
lime	4175
lime & shale	4505
lime	4662
lime & shale	4805
lime	5241
lime w/ breaks	5350
lime	5627
lime, shale & sand	5686
sand	5750
Total Depth	

TOPS: SCOUT	
Lansing	4541
Cherokee	5376
Morrow shale	5672
Morrow sand	5676

RECEIVED
 STATE CORPORATION COMMISSION
 DEC 4 1973
 CONSERVATION DIVISION
 Wichita, Kansas