


15-119-10152-0000

STATE OF KANSAS  
STATE CORPORATION COMMISSION

WELL PLUGGING RECORD

Give All Information Completely  
Make Required Affidavit  
Mail or Deliver Report to:  
Conservation Division  
State Corporation Commission  
212 North Market, Insurance Bldg.  
Wichita, Kansas

Meade County, Sec. 12 Twp. 33S Rge. ~~29~~ 29 (W)  
Location as "NE/CNW/SW" or footage from lines 660' from north and 660' from east  
Lease Owner Diamond Shamrock Corporation  
Lease Name Joe S. Fletcher Well No. 4  
Office Address Box 631, Amarillo, Texas 79105  
Character of Well (completed as Oil, Gas or Dry Hole) Oil  
Date well completed 10-23 1959  
Application for plugging filed 4-20 1972  
Application for plugging approved 4-24 1972  
Plugging commenced 5-20- 1972  
Plugging completed 5-22 1972  
Reason for abandonment of well or producing formation No longer capable of producing  
If a producing well is abandoned, date of last production March 19 67  
Was permission obtained from the Conservation Division or its agents before plugging was commenced? Yes

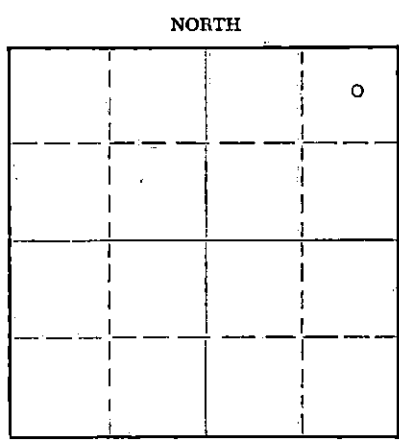

Locate well correctly on above Section Plat

Name of Conservation Agent who supervised plugging of this well E. Eves  
Producing formation Morrow Sand Depth to top 5562 Bottom 5583 Total Depth of Well 5810 Feet  
Show depth and thickness of all water, oil and gas formations.

OIL, GAS OR WATER RECORDS

CASING RECORD

FORMATION	CONTENT	FROM	TO	SIZE	PUT IN	PULLED OUT
Morrow Sand	Oil	5562	5583	9 5/8"	1,534	
				4 1/2"	5,640	2,025'

Describe in detail the manner in which the well was plugged, indicating where the mud fluid was placed and the method or methods used in introducing it into the hole. If cement or other plugs were used, state the character of same and depth placed, from \_\_\_\_\_ feet to \_\_\_\_\_ feet for each plug set.  
Set 30 sacks cement from 5,680' to 5,350'  
Set 35 sacks cement from 900' to 800'  
Set 15 sacks cement from 45' to 3'.  
Welded plate on surface casing.

RECEIVED  
STATE CORPORATION COMMISSION  
MAY 25 1972  
CONSERVATION DIVISION  
Wichita, Kansas

(If additional description is necessary, use BACK of this sheet)  
Name of Plugging Contractor Bob Sargent Casing Pulling  
Address Box 506, Liberal, Kansas 67901

STATE OF Texas, COUNTY OF Potter, ss.  
W. W. Killingsworth (employee of owner) or ~~owner or operator~~ of the above-described well, being first duly sworn on oath, says: That I have knowledge of the facts, statements, and matters herein contained and the log of the above-described well as filed and that the same are true and correct. So help me God.

(Signature) W. W. Killingsworth  
Box 631, Amarillo, Texas 79105 (Address)

SUBSCRIBED AND SWORN to before me this 23rd day of May, 19 72  
PAULINE POWELL  
Notary Public  
My commission expires 6-1-73

SHAMROCK OIL & GAS CORP.-  
JOE S. FLETCHER WELL NO. 4

CONS-

WELL LOG

