

STATE OF KANSAS
STATE CORPORATION COMMISSION


Give All Information Completely
Make Required Affidavit
Mail or Deliver Report to:
Conservation Division
of the Corporation Commission
11 No. Broadway
Wichita, Kansas

WELL PLUGGING RECORD

Meade County, Sec. 13 Twp. 33 Rge. (E) 29 (W)

Location as "NE/CNW/SW" or footage from lines Gen. SW NE
Lease Owner Lario Oil & Gas Company
Lease Name Adlard Well No. 1
Office Address 301 S. Market, Wichita 2, Kansas
Character of Well (completed as Oil, Gas or Dry Hole) Dry Hole
Date well completed January 22, 19 62
Application for plugging filed January 22, 19 62
Application for plugging approved January 22, 19 62
Plugging commenced January 23, 19 62
Plugging completed January 23, 19 62
Reason for abandonment of well or producing formation Dry Hole

NORTH

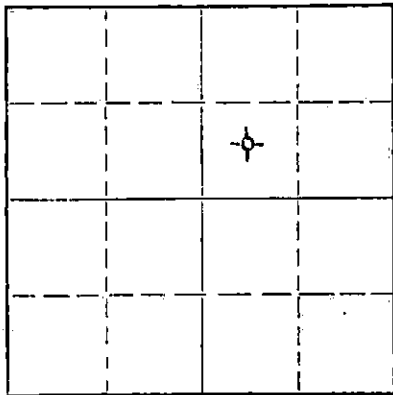

Locate well correctly on above Section Plat

If a producing well is abandoned, date of last production 19
Was permission obtained from the Conservation Division or its agents before plugging was commenced? Yes

Name of Conservation Agent who supervised plugging of this well W. L. LacCamp
Producing formation Depth to top Bottom Total Depth of Well 5850 Feet
Show depth and thickness of all water, oil and gas formations.

OIL, GAS OR WATER RECORDS

CASING RECORD

FORMATION	CONTENT	FROM	TO	SIZE	PUT IN	PULLED OUT
				8 5/8"	1520 Set @	1518' Cem. w/ 300 sacks

Describe in detail the manner in which the well was plugged, indicating where the mud fluid was placed and the method or methods used in introducing it into the hole. If cement or other plugs were used, state the character of same and depth placed, from feet to feet for each plug set.

Heavy mud from total depth to 500'. Set plug with 1/4 sack hulls, 20 sacks cement. Heavy mud to 35', 1/4 sack hulls, 10 sacks cement to base of cellar.

RECEIVED
STATE CORPORATION COMMISSION

1-31-62 JAN 31 1962

CONSERVATION DIVISION
Wichita, Kansas

(If additional description is necessary, use BACK of this sheet)
Name of Plugging Contractor Patton Drilling Company, Inc.
Address Wichita, Kansas

STATE OF KANSAS, COUNTY OF SEDGWICK, ss. Leo Ross (employee of owner) or (owner) of the above-described well, being first duly sworn on oath, says: That I have knowledge of the facts, statements, and matters herein contained and the log of the above-described well as filed and that the same are true and correct. So help me God.

(Signature) Leo Ross
301 S. Market, Wichita 2, Kansas (Address)

SUBSCRIBED AND SWORN TO before me this 25th day of January, 1962

My commission expires July 21, 1962
Notary Public.

LARIO OIL & GAS COMPANY
 No. 1 Adlard
 Cen. SW/4 NE/4 Sec. 13-33S-29W
 Meade County, Kansas

Drilling Commenced: December 21, 1961
 Drilling Completed: January 22, 1962
 Well Plugged: January 23, 1962
 Drilling Contractor: Patton Drilling Company, Inc.
 Total Depth 5850'
 I. P. - Dry and Abandoned

CASING RECORD:
 8 5/8" 1520' Set @ 1518' Cem. w/ 300 sx.

Formation	Depth	GEOLOGICAL TOPS - ELEC. LOG
		Elevation 2461'
Sand and red bed	200	Wreford 2884'
Sand, red bed, shale & shells	700	Council Grove 2986'
Red bed and shale	880	Heebner 4304'
Sand	945	Toronto 4324'
Shale	1020	Lansing-Kansas City 4476'
Shale, anhydrite, shells	1300	Marmaton 5104'
Anhydrite w/ shale	1660	Cherokee 5259'
Shale and anhydrite	2035	Morrow Shale 5596'
Lime and shale	2245	Morrow Sand 5634'
Shale and anhydrite	2475	Sand 5675'
Lime and shale	3015	Chester 5707'
Shale & chalky lime	3071	Total Depth 5851'
Chalky lime and shale	3292	
Lime and shale	3573	
Shale and sandy lime	3703	
Shale and lime	4525	
Lime w/ some shale	4548	
Shale	4578	
Lime, chalky	4753	
Lime	4889	
Shale, sandy lime	4934	
Lime	5012	
Lime and shale	5032	
Lime	5115	
Lime w/ shale	5173	
Shale and chalky lime	5244	
Lime	5267	
Lime, chalky and shale	5315	
Shale and lime	5380	
Lime	5400	
Chalky lime w/ shale	5460	
Lime	5532	
Lime w/ shale streaks	5582	
Lime and sand	5620	
Sand	5630	
Sandy shale w/ lime	5700	
Lime and shale	5705	
Lime	5850	

RECEIVED
 STATE CORPORATION COMMISSION
 JAN 31 1962
 CONSERVATION DIVISION
 Wichita, Kansas

I hereby certify that this is a true and correct log of the above mentioned well.

Leo Ross
 Leo Ross

STATE OF KANSAS)
) ss
 COUNTY OF SEDGWICK)

Subscribed and sworn to before me, a notary public, in and for said County and State this 26th day of January, 1962.

Frances Leslie
 Notary Public

My Commission expires July 21, 1962.