


STATE OF KANSAS  
STATE CORPORATION COMMISSION

WELL PLUGGING RECORD

Give All Information Completely  
Make Required Affidavit  
Mail or Deliver Report to  
Conservation Division  
State Corporation Comm.  
245 North Water  
Wichita, KS, 67202.

Sumner County, Sec. 24 Twp. 30S Rge. 2 E/W  
Location as "NE/CNW 1/4 SW 1/4" or footage from lines  
SE NW SW

Lease Owner Wheatland Oil & Gas, Inc.  
Lease Name Erker Well No. 1  
Office Address 501 Petroleum Bldg., Wichita, KS 67202  
Character of Well (Completed as Oil, Gas or Dry Hole)  
Dry & Abandoned

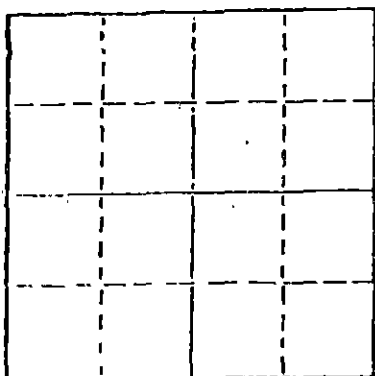

Locate well correctly on above  
Section Plot

Date Well completed 9-25-80 1980  
Application for plugging filed 9-26 19  
Application for plugging approved 9-26 1980  
Plugging commenced 9-26 1980  
Plugging completed 9-26 1980

Reason for abandonment of well or producing formation  
D & A  
If a producing well is abandoned, date of last production  
19

Was permission obtained from the Conservation Division or  
its agents before plugging was commenced? Yes

Name of Conservation Agent who supervised plugging of this well William T. Owen  
Producing formation \_\_\_\_\_ Depth to top \_\_\_\_\_ Bottom \_\_\_\_\_ Total Depth of Well 13855  
Show depth and thickness of all water, oil and gas formations.


OIL, GAS OR WATER RECORDS

CASING RECORD

| FORMATION | CONTENT | FROM | TO | SIZE   | PUT IN | PULLED OUT |
|-----------|---------|------|----|--------|--------|------------|
|           |         |      |    | 8 5/8" | 456'   | None       |
|           |         |      |    |        |        |            |
|           |         |      |    |        |        |            |
|           |         |      |    |        |        |            |

Describe in detail the manner in which the well was plugged, indicating where the mud fluid  
was placed and the method or methods used in introducing it into the hold. If cement or other  
plugs were used, state the character of same and depth placed, from \_\_\_\_\_ feet to  
\_\_\_\_\_ feet for each plug set.

1st plug @ 460' w/ 50 sx. 50-50 posmix  
2nd plug @ 40' w/ 10 sx. 50-50 posmix  
5 sx. in rat hole

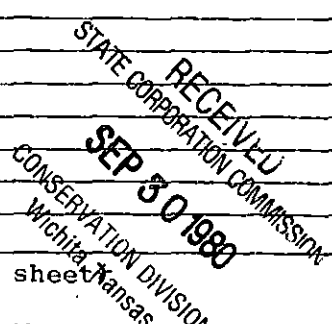

(If additional description is necessary, use BACK of this sheet)

Name of Plugging Contractor Ramco Drilling Corp.

STATE OF Kansas COUNTY OF Butler, ss.  
J. V. Crawford (employee of owner) or (owner or operator)  
of the above-described well, being first duly sworn on oath, says: That I have knowledge of  
the facts, statements, and matters herein contained and the log of the above-described well  
as filed and that the same are true and correct. So help me God.

(Signature) J. V. Crawford  
430 Lioba, Andover, KS 67002  
(Address)

SUBSCRIBED AND SWORN TO before me this 29th day of September, 19 80

Sandra Kay May  
Sandra Kay May Notary Public.

My commission expires 6-5-84

