


STATE OF KANSAS
STATE CORPORATION COMMISSION

Form CP-4

Give All Information Completely
Make Required Affidavit
Mail or Deliver Report to:
Conservation Division
State Corporation Commission
212 No. Market
Wichita, Kansas 67202

WELL PLUGGING RECORD

Sumner County, Sec. 21 Twp. 30 Rge. 2 (E) W (W)
Location as "NE/CNW%SW%" or footage from lines SW NW NW
Lease Owner Hummond Oil Inc.
Lease Name Orr #1 Well No. S.W.D.
Office Address 821 Union National Bldg.; Wichita, Ks. 67202
Character of Well (completed as Oil, Gas or Dry Hole) _____
Date well completed _____ 19____
Application for plugging filed October 1971
Application for plugging approved October 1971
Plugging commenced November 10 1971
Plugging completed November 12 1971
Reason for abandonment of well or producing formation _____

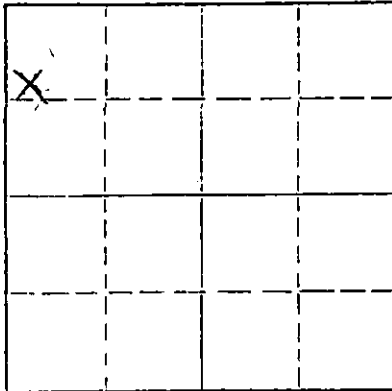

Locate well correctly on above
Section Plat

If a producing well is abandoned, date of last production _____ 19____
Was permission obtained from the Conservation Division or its agents before plugging was commenced? Yes

Name of Conservation Agent who supervised plugging of this well Eugene Graham
Producing formation _____ Depth to top _____ Bottom _____ Total Depth of Well 3868 Feet
Show depth and thickness of all water, oil and gas formations.

OIL, GAS OR WATER RECORDS

CASING RECORD

FORMATION	CONTENT	FROM	TO	SIZE	PUT IN	PULLED OUT
				8 5/8"	255	None
				4 1/2"	3227	2625

Describe in detail the manner in which the well was plugged, indicating where the mud fluid was placed and the method or methods used in introducing it into the hole. If cement or other plugs were used, state the character of same and depth placed, from _____ feet to _____ feet for each plug set.

November 10, 1971 Plugged off bottom. Dumped sand to 3100'. Mixed and dumped 5 sx of cement to 3060'.
November 12, 1971 Plugged off top. Set 10' rock bridge at 250'. Mixed and dumped 20 sx of cement, mudded casing to 40', 10' rock from 40' to 30'. Mixed and dumped 10 sx of cement from 30' to base of cellar.

RECEIVED
STATE CORPORATION COMMISSION
DEC 10 1971
CONSERVATION DIVISION
Wichita, Kansas

(If additional description is necessary, use BACK of this sheet)
Name of Plugging Contractor RUSS CASING PULLING, INC.
Address P. O. Box 1082 ; Great Bend, Kansas 67530

STATE OF KANSAS, COUNTY OF SEDGWICK, ss.
C. E. Leith (employee of owner) or (owner or operator) of the above-described

well, being first duly sworn on oath, says: That I have knowledge of the facts, statements, and matters herein contained and the log of the above-described well as filed and that the same are true and correct. So help me God.

(Signature) C. E. Leith
6409 E. 14th St - Wichita, Kansas
(Address)

SUBSCRIBED AND SWORN TO before me this 9th day of December, 1971

My commission expires May 1, 1974
Scharla L. Herrington
Scharla L. Herrington Notary Public.

FROM	TO	
0	10	Top Soil
10	255	Gray shale and red bed
255	795	Shale
795	1755	Shale & lime
1755	1895	Lime & shale
1895	2510	Shale & lime
2510	2620	Lime & shale
2620	2765	Shale & lime
2765	2828	Lime and shale
2828	2874	Shale and stal. sand
2874	2950	Stal. sand
2950	3091	Shale and lime
3091	3612	Lime
3612	3715	Lime and shale
3715	3868	Lime
3868		Total Depth

Elevation: 1352 D.F.

RECEIVED
 STATE CORPORATION COMMISSION
 OCT 4 1971
 CONSERVATION DIVISION
 Wichita, Kansas

STATE OF KANSAS
 COUNTY OF BARTON ss

T. D. Sweetman, President of Sweetman Drilling, Inc., being first duly sworn on oath says: That I have knowledge of the facts, statements and matters herein contained and the log of the above described well as filed and that the same are true and correct.

T. D. Sweetman
 T. D. Sweetman

Subscribed and sworn before me this 4th day of November, 1968.

Beata L. Boyd
 Notary Public Barton County



Commission Expires 5-9-71