

15-191-20076-0000
R

STATE OF KANSAS
STATE CORPORATION COMMISSION

Form CP-4

Give All Information Completely
Make Required Affidavit
Mail or Deliver Report to:
Conservation Division
State Corporation Commission
212 No. Market
Wichita, Kansas 67202

WELL PLUGGING RECORD

Sumner County, Sec. 20 Twp. 30 Rge. 2 (E) W (W)

Location as "NE/CNW/SE/SW" or footage from lines SW NE NE

Lease Owner Hummon Oil Inc.

Lease Name Armstrong Well No. # 1

Office Address 821 Union Nat'l. Bldg., Wichita, Ks. 67202

Character of Well (completed as Oil, Gas or Dry Hole)

Date well completed 19

Application for plugging filed October 19 71

Application for plugging approved October 19 71


Plugging commenced November 3 19 71

Plugging completed November 5 19 71

Reason for abandonment of well or producing formation

If a producing well is abandoned, date of last production 19

Was permission obtained from the Conservation Division or its agents before plugging was commenced? Yes

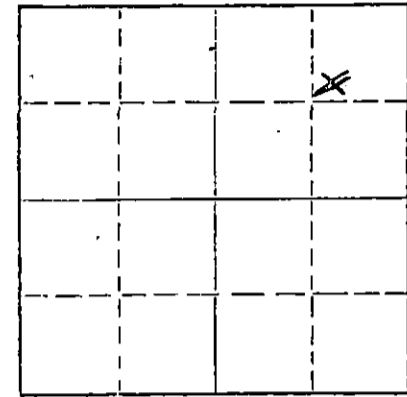

Locate well correctly on above Section Plat

Name of Conservation Agent who supervised plugging of this well Eugene Graham

Producing formation Depth to top Bottom Total Depth of Well 3790 Feet

Show depth and thickness of all water, oil and gas formations.

OIL, GAS OR WATER RECORDS

CASING RECORD

FORMATION	CONTENT	FROM	TO	SIZE	PUT IN	PULLED OUT
				8 5/8"	250	None
				5 1/2"	3471	2500

Describe in detail the manner in which the well was plugged, indicating where the mud fluid was placed and the method or methods used in introducing it into the hole. If cement or other plugs were used, state the character of same and depth placed, from feet to feet for each plug set.

November 3, 1971 Plugged off bottom. Dumped sand to 3100'. Mixed and dumped 5 sx of cement to 3060'.

November 5, 1971 Plugged off top. Set 10' rock bridge at 240'. Mixed and dumped 20 sx of cement, mudded casing to 40'. Set 10' rock bridge from 40' to 30'. Mixed and dumped 10 sx of cement from 30' to base of cellar.

RECEIVED
STATE CORPORATION COMMISSION
DEC 10 1971
CONSERVATION DIVISION
Wichita, Kansas

Name of Plugging Contractor RUSS CASING PULLING, INC. (If additional description is necessary, use BACK of this sheet)

Address P. O. Box 1082 ; Great Bend, Kansas 67530

STATE OF KANSAS, COUNTY OF SEDGWICK, ss. C. E. Leith

(employee of owner) or (owner or operator) of the above-described well, being first duly sworn on oath, says: That I have knowledge of the facts, statements, and matters herein contained and the log of the above-described well as filed and that the same are true and correct. So help me God.

(Signature): [Signature] 6409 E. 14th St. WICHITA, KANSAS (Address)

SUBSCRIBED AND SWORN TO before me this 9th day of December, 19 71

My commission expires May 1, 1974

[Signature] Scharla L. Herrington Notary Public.

15-191-20076-0000

RECEIVED
STATE CORPORATION COMMISSION
OCT 4 1971
CONSERVATION DIVISION
Wichita, Kansas

WELL LOG
Armstrong #1
SW/NE/NE
Sec. 20- Twp. 30S-Range 2W
Sumner County, Kansas

1968

FROM	TO	DESCRIPTION
0	250	Soil & Shale
250	625	Shale
625	2870	Shale & Lime
2870	2905	Sand
2905	3055	Shale & Lime
3055	3790	Lime
3790		Total Depth



STATE OF KANSAS
COUNTY OF BARTON ss





T. D. Sweetman
T. D. Sweetman

Subscribed and sworn before me this 2nd Day of July, 1968.

Reata L Boyd
Notary Public Barton County

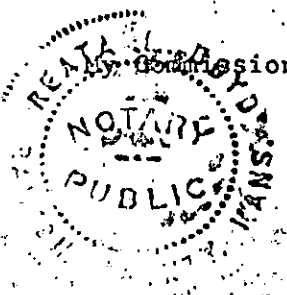

RECEIVED
STATE CORPORATION COMMISSION
OCT 4 1971
CONSERVATION DIVISION
Wichita, Kansas