


STATE OF KANSAS  
STATE CORPORATION COMMISSION

Give All Information Completely  
Make Required Affidavit  
Mail or Deliver Report to:  
Conservation Division  
State Corporation Commission  
211 No. Broadway  
Wichita, Kansas

WELL PLUGGING RECORD

Meade County. Sec. 18 Twp. 33S Rge. 29W (E) (W)  
Location as "NE/CNW/SW" or footage from lines C SE 1/4  
Lease Owner Alamo Corporation Et Al  
Lease Name Connor Well No. 1-18  
Office Address Box 985, Liberal, Kansas  
Character of Well (completed as Oil, Gas or Dry Hole) Dry hole  
Date well completed August 11 19 58  
Application for plugging filed August 11 19 58  
Application for plugging approved August 11 19 58  
Plugging commenced August 11 19 58  
Plugging completed August 11 19 58  
Reason for abandonment of well or producing formation Dry hole

NORTH

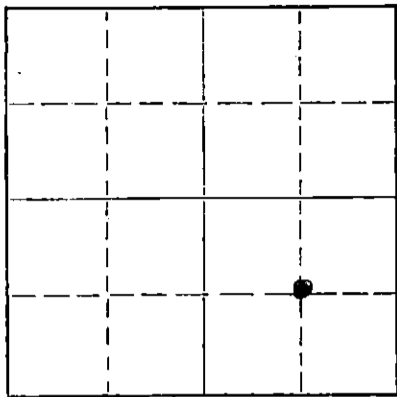

Locate well correctly on above  
Section Plat

If a producing well is abandoned, date of last production \_\_\_\_\_ 19\_\_\_\_  
Was permission obtained from the Conservation Division or its agents before plugging was commenced? Yes

Name of Conservation Agent who supervised plugging of this well Mr. M. A. Rives  
Producing formation \_\_\_\_\_ Depth to top \_\_\_\_\_ Bottom \_\_\_\_\_ Total Depth of Well 5950 Feet  
Show depth and thickness of all water, oil and gas formations.

OIL, GAS OR WATER RECORDS

CASING RECORD

FORMATION	CONTENT	FROM	TO	SIZE	PUT IN	PULLED OUT
				8-5/8"	1575'	None

Describe in detail the manner in which the well was plugged, indicating where the mud fluid was placed and the method or methods used in introducing it into the hole. If cement or other plugs were used, state the character of same and depth placed, from \_\_\_\_\_ feet to \_\_\_\_\_ feet for each plug set.

Filled hole with mud to 550'; set plug at 550'. Pumped 35 sacks on plug through pipe (with Halliburton pump truck). Filled to 35' with mud, set plug at 35', filled to bottom of cellar with 15 sacks cement.

(If additional description is necessary, use BACK of this sheet)

Name of Plugging Contractor Graham-Michaelis Drilling Company  
Address 211 North Broadway, Wichita 2, Kansas

STATE OF KANSAS, COUNTY OF SEWARD, ss.  
Glenn E. Thomas (employee of owner) or (owner or operator) of the above-described well, being first duly sworn on oath, says: That I have knowledge of the facts, statements, and matters herein contained and the log of the above-described well as filed and that the same are true and correct. So help me God.

(Signature) Glenn E. Thomas  
Box 985 - Liberal, Kansas (Address)

SUBSCRIBED AND SWORN TO before me this 10<sup>th</sup> day of August, 19 58

My commission expires 5-23-61

J. T. Mabrey  
Notary Public

RECEIVED  
STATE CORPORATION COMMISSION  
AUG 16 1958  
CONSERVATION DIVISION

PLUGGING  
FILE SEC 18 T 33 R 29W  
BOOK PAGE 123 LINE 34