

15-119-01004-0000


STATE OF KANSAS
STATE CORPORATION COMMISSION

WELL PLUGGING RECORD

Give All Information Completely
Make Required Affidavit
Mail or Deliver Report to:
Conservation Division
State Corporation Commission
212 North Market, Insurance Bldg.
Wichita, Kansas

Meade County. Sec. 18 Twp. 33S Rge. 29 (W)

Location as "NE/CNW/SW" or footage from lines 660' fr. north & 1980' fr. west
Lease Owner: The Shamrock Oil and Gas Corporation
Lease Name: Arthur L. Vaught Well No. 1
Office Address: Box 631, Amarillo, Texas
Character of Well (completed as Oil, Gas or Dry Hole) Dry Hole
Date well completed 3-22 19 60
Application for plugging filed 3-22 19 60
Application for plugging approved 3-22 19 60
Plugging commenced 3-22 19 60
Plugging completed 3-22 19 60
Reason for abandonment of well or producing formation Dry

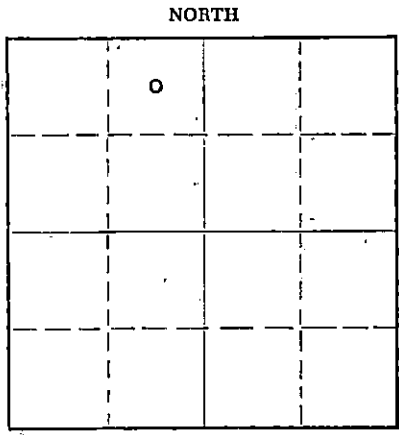

Locate well correctly on above Section Plot

If a producing well is abandoned, date of last production None 19
Was permission obtained from the Conservation Division or its agents before plugging was commenced? Yes

Name of Conservation Agent who supervised plugging of this well Mr. Bill Lackamp, State Engineer
Producing formation None Depth to top Bottom Total Depth of Well 5,908 Feet
Show depth and thickness of all water, oil and gas formations.

OIL, GAS OR WATER RECORDS

CASING RECORD

FORMATION	CONTENT	FROM	TO	SIZE	PUT IN	PULLED OUT
				9 5/8"	1,522.83'	-0-

Describe in detail the manner in which the well was plugged, indicating where the mud fluid was placed and the method or methods used in introducing it into the hole. If cement or other plugs were used, state the character of same and depth placed, from feet to feet for each plug set.
Filled hole with heavy drilling mud to 550'. Pushed 9 5/8" plug and 1/2 sacks hulls to 550'. Displaced 9m 5/8" plug and 1/2 sack hulls to 35'. Cemented with 20 sacks cement to base of cellar.

RECEIVED
STATE CORPORATION COMMISSION
MAR 25 1960
CONSERVATION DIVISION

(If additional description is necessary, use BACK of this sheet)
Name of Plugging Contractor Halliburton Oil Well Cementing Company
Address Liberal, Kansas

STATE OF Texas COUNTY OF Potter, ss.
T. S. Clopton (employee of owner) of the above-described well, being first duly sworn on oath, says: That I have knowledge of the facts, statements, and matters herein contained and the log of the above-described well as filed and that the same are true and correct. So help me God.

(Signature) T. S. Clopton
Box 631, Amarillo, Texas (Address)

SUBSCRIBED AND SWORN to before me this 24th day of March, 19 60
PAULINE POWELL Notary Public
Potter County, Texas Notary Public.

My commission expires 6-1-61

ARTHUR L. VAUGHT NO. 1
Section 18, Township 33 South, Range 29 West
Meade County, Kansas

0'	-	360'	Sand, shale & shells
360'	-	944'	Shale, Shells, & red bed
944'	-	2,330'	Shale & shells
2,330'	-	2,455'	Shale & lime
2,455'	-	2,601'	Shale & shells
2,601'	-	2,739'	Lime & shale
2,739'	-	2,868'	Lime
2,868'	-	3,033'	Lime & shale
3,033'	-	3,090'	Lime
3,090'	-	3,193'	Lime & shale
3,193'	-	3,255'	Lime
3,255'	-	4,622'	Lime & shale
4,622'	-	4,690'	Lime
4,690'	-	5,605'	Lime & shale
5,605'	-	5,618'	Lime
5,618'	-	5,908'	Lime & shale.

RECEIVED
STATE CORPORATION COMMISSION
MAR 25 1960
CONSERVATION DIVISION
Wichita, Kansas