

15-119-10002-0000

R

STATE OF KANSAS
STATE CORPORATION COMMISSION

Form CP-4

WELL PLUGGING RECORD


Give All Information Completely
Make Required Affidavit
Mail or Deliver Report to:
Conservation Division
State Corporation Commission
211 No. Broadway
Wichita, Kansas

Meade County, Sec. 19 Twp. 33 Rge. (E) 29 (W)

Location as "NE/CNW/SW" or footage from lines 135' E of C SE NE

Lease Owner Powell & Stone
Lease Name Banker Well No. 1
Office Address c/o Bill Brailey, Box 768, Woodward, Okla. 73801
Character of Well (completed as Oil, Gas or Dry Hole) Oil
Date well completed January 22, 1958 19
Application for plugging filed June 2, 1972 19
Application for plugging approved June 7, 1972 19
Plugging commenced 6/5/ 19 72
Plugging completed 6/8/7 19 72
Reason for abandonment of well or producing formation Non-Commercial

NORTH

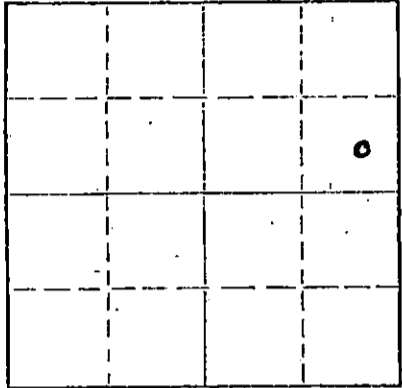

Locate well correctly on above Section Plat

If a producing well is abandoned, date of last production date unknown 19 71
Was permission obtained from the Conservation Division or its agents before plugging was commenced? Yes

Name of Conservation Agent who supervised plugging of this well Edgar Eves
Producing formation Morrow Depth to top 5789' Bottom 5824' Total Depth of Well 5954' Feet
Show depth and thickness of all water, oil and gas formations.

OIL, GAS OR WATER RECORDS

CASING RECORD

FORMATION	CONTENT	FROM	TO	SIZE	PUT IN	PULLED OUT
Morrow Sand	Oil & Gas	5789'	5824'	8 5/8" 5 1/2"	1541' 5864'	None 4415'

Describe in detail the manner in which the well was plugged, indicating where the mud fluid was placed and the method or methods used in introducing it into the hole. If cement or other plugs were used, state the character of same and depth placed, from _____ feet to _____ feet for each plug set.

25 sks. cement at 5,600' to 5,799'.
Pump 35 sks. cement at 900' to 800'
Put 15 sks. cement at 45' to 0'.

RECEIVED
STATE CORPORATION COMMISSION
JUN 20 1972
CONSERVATION DIVISION
Wichita, Kansas

(If additional description is necessary, use BACK of this sheet)

Name of Plugging Contractor SARGENT'S CASING PULLING SERVICE
Address P.O. Box 506, Liberal, Kansas 67901

STATE OF KANSAS, COUNTY OF SEWARD, ss.


ROBERT SARGENT (owner or operator) of the above-described well, being first duly sworn on oath, says: That I have knowledge of the facts, statements, and matters herein contained and the log of the above-described well as filed and that the same are true and correct. So help me God.

(Signature) Robert Sargent
P.O. Box 506, Liberal, Kansas 67901
(Address)

SUBSCRIBED AND SWORN TO before me this 13th day of June, 1972

Mona M. Clark
Notary Public.

My commission expires

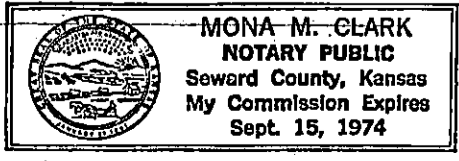

Government?

Please find attached a copy of
the drillers Log on the Stone
Banker #1.

This well is being plugged
and abandon and all other forms
have been mailed in. Would
you please see that this
form finds its proper spot.

Thank You.
W. B. Braluy

DRILLERS LOG

Operator: Alamo, Division of Rug-Sheen, Inc.
Lubbock National Bank Building
Lubbock, Texas

Elevation:

Date Commenced: October 14, 1957

Contractor: Midwestern Drillers, Inc.
1206 Mid-Continent Building
Tulsa 3, Oklahoma

Date Completed: November 13, 1957

Total Depth: 5,954' RB

Lease Name: Banker No. 1

Lease Location: SE/4 Sec. 19, T33S, R29W
Meade County, Kansas

Casing Record: Surface - Set 1,541' of 8-5/8" casing w/750 sacks pozmix w/2% c.c.
Production - Set 5,874' of 5 1/2" casing w/150 sacks Pozmix w/2% c.c.

<u>FORMATION</u>	<u>DEPTH FROM ROTARY BUSHING</u>
	0
Clay and sand	560
Red bed and gypsum	1000
Red bed	1553
Anhydrite and shale	2340
Shale and lime	2705
Lime and shale	2995
Lime and shale	3293
Chalk	3336
Limey shale	3353
Lime	3460
Lime and shale	3500
Chalky lime and shale	3576
Shaley lime and chalk	3752
Lime and shale	3850
Chalk, lime and shale	3940
Lime	3985
Lime and shale with chert	4118
Shale and lime	4280
Lime and shale	4555
Lime and shale	4631
Lime and shale	4710
Lime, shale and chert	4775
Lime and shale	4825
Lime, chert and shale	4890
Lime and shale	5065
Lime, shale and chalk	5117
Lime and shale with chalk streaks	5262
Lime and shale	5324
Lime and shale	5467
Lime and shale	5600
Lime and shale	5727
Lime and shale	5765
Shale	5799
Lime and shale	5860
Lime and sand	5872
Lime and shale	5954
	TD

RECEIVED
STATE CORPORATION COMMISSION
JUN 7 1972
CONSERVATION DIVISION
Wichita, Kansas

Ran DST #1 @ 5,860'
Ran Electric Log
Ran 5,874' of 5 1/2" casing
Ran Temperature Survey

I hereby certify that the above is a true and correct copy of Drillers Log of the Banker No. 1 of Alamo, Division of Rug-Sheen, Inc.

MIDWESTERN DRILLERS, INC.

F. W. Wyant
F. W. Wyant

Subscribed and sworn to before me this 18th day of November, 1957.

C. Williams
Notary Public

My Commission Expires:
February 21, 1961