


WELL PLUGGING RECORD

Give All Information Completely
Make Required Affidavit
Mail or Deliver Report to:
Conservation Division
State Corporation Commission
P. O. Box 17027
Wichita, Kansas 67217
NORTH

Meade County, Sec. 20 Twp. 33S Rge. (E) 29 (W)
Location as "NE/CNW/SW" or footage from lines: C SE NW
Lease Owner: Imperial Oil Company
Lease Name: Singley Well No. 1
Office Address: 720 Fourth Financial Center, Wichita
Character of Well (completed as Oil, Gas or Dry Hole): Dry Hole
Date well completed: March 9, 19 75
Application for plugging filed: 19
Application for plugging approved: 19
Plugging commenced: March 9, 19 75
Plugging completed: March 9, 19 75
Reason for abandonment of well or producing formation: Dry Hole

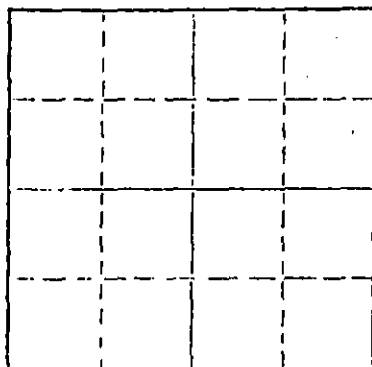

Locate well correctly on above Section Plot

If a producing well is abandoned, date of last production: 19
Was permission obtained from the Conservation Division or its agents before plugging was commenced? Yes (Clarence Thomas of Garden City)

Name of Conservation Agent who supervised plugging of this well:
Producing formation: Depth to top: Bottom: Total Depth of Well: 5975 Feet
Show depth and thickness of all water, oil and gas formations.

OIL, GAS OR WATER RECORDS

CASING RECORD

FORMATION	CONTENT	FROM	TO	SIZE	PUT IN	PULLED OUT
	Surface Casing	0	1526'	8-5/8"	1526'	None

Describe in detail the manner in which the well was plugged, indicating where the mud fluid was placed and the method or methods used in introducing it into the hole. If cement or other plugs were used, state the character of same and depth placed, from feet to feet for each plug set.

Heavy Mud from Total Depth to 1500 Feet,
35 sax cement; Heavy Mud to 40 Feet,
15 sax cement 40' to 0; 2 sax cement
in rat hole. Job completed @ 7:00 P.M.


(If additional description is necessary, use BACK of this sheet)

Name of Plugging Contractor: Halliburton
Address: R.R. 1, Box 112, Liberal, Ks. 67901

STATE OF KANSAS COUNTY OF SEDGWICK
T. M. McCaul, Jr. of Sage Drilling Co. (employee of owner or (owner or operator) of the above described well)

being first duly sworn on oath, says: That I have knowledge of the facts, statements, and matters herein contained and the top of the above described well as filed and that the same are true and correct. So help me God.

(Signature) T. M. McCaul, Jr.
500 Bitting Bldg., Wichita, Kans.
(Address)

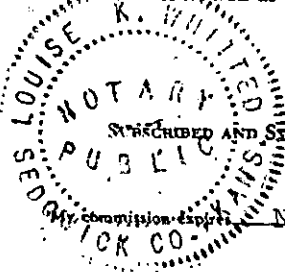

Subscribed and sworn to before me this 14th day of March 19 75
November 26, 1978.

(Signature) Louise K. Whitted
Louise K. Whitted, Notary Public.

RECEIVED
STATE CORPORATION COMMISSION

RECEIVED
24 1975 STATE CORPORATION COMMISSION

CONSERVATION DIVISION | 24 1975 3-24-75
Wichita, Kansas

CONSERVATION DIVISION
Wichita, Kansas

DRILLERS LOG

SINGLEY NO. 1

CASING RECORD:	OPERATOR: Imperial Oil Company	DESCRIPTION:
8-5/8" set @ 1526' w/750 sax cement	CONTRACTOR: Sage Drilling Co.	C SE NW Sec. 20-33S-29W Meade Co., Kansas
TOTAL DEPTH: 5975'	COMMENCED: February 24, 1975	ELEVATION: 2680KB
	COMPLETED: March 9, 1975	


<u>FORMATION</u>	<u>FROM</u>	<u>TO</u>	<u>REMARKS</u>
Surface Soil & Sand	0	80	
Clay & Sand	80	940	
Red Bed & Sand	940	1535	
Anhydrite	1535	2085	
Anhydrite & Shale	2085	2515	
Shale	2515	2920	
Shale & Dolomite	2920	3105	
Dolomite	3105	3540	
Lime & Shale	3540	5975	D&A

I certify that this is a true and correct copy of the above log to the best of my knowledge.

SAGE DRILLING CO., INC.

T. M. McCaul, Jr.

By _____
T. M. McCaul, Jr.

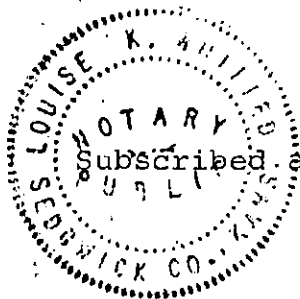

Subscribed and sworn to before me this 20th day of March, 1975.

Louise K. Whitted
Louise K. Whitted, Notary Public

My commission expires:
November 26, 1978.

RECEIVED
STATE CORPORATION COMMISSION
3/24/75
CONSERVATION DIVISION
Wichita, Kansas