

STATE OF KANSAS  
STATE CORPORATION COMMISSION


Form CP-4

Give All Information Completely  
Make Required Affidavit  
Mail or Deliver Report to:  
Conservation Division  
State Corporation Commission  
211 No. Broadway  
Wichita, Kansas

WELL PLUGGING RECORD

Meade County, Sec. 21 Twp. 33S Rge. 29W (Ex (W)

Location as "NE/CNWxSWx" or footage from lines C-SE NW SWNE SW  
Lease Owner Bovaird Supply Company  
Lease Name Holmes Well No. 1  
Office Address 525 South Western, Liberal, Kansas 67901  
Character of Well (completed as Oil, Gas or Dry Hole) \_\_\_\_\_  
Date well completed \_\_\_\_\_ 19\_\_\_\_  
Application for plugging filed \_\_\_\_\_ 19\_\_\_\_  
Application for plugging approved \_\_\_\_\_ 19\_\_\_\_  
Plugging commenced \_\_\_\_\_ 1/24/ 19 70  
Plugging completed \_\_\_\_\_ 1/28/ 19 70  
Reason for abandonment of well or producing formation \_\_\_\_\_

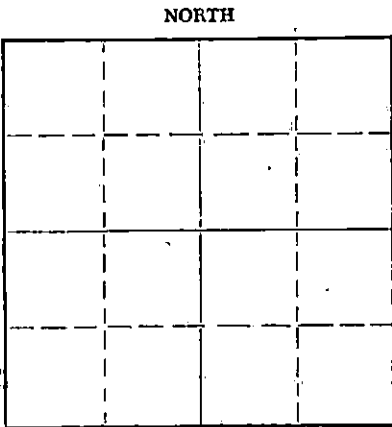

Locate well correctly on above Section Plat

If a producing well is abandoned, date of last production \_\_\_\_\_ 19\_\_\_\_  
Was permission obtained from the Conservation Division or its agents before plugging was commenced? \_\_\_\_\_

Name of Conservation Agent who supervised plugging of this well \_\_\_\_\_  
Producing formation \_\_\_\_\_ Depth to top \_\_\_\_\_ Bottom \_\_\_\_\_ Total Depth of Well 5949 Feet  
Show depth and thickness of all water, oil and gas formations.

OIL, GAS OR WATER RECORDS

CASING RECORD

FORMATION	CONTENT	FROM	TO	SIZE	PUT IN	PULLED OUT

Describe in detail the manner in which the well was plugged, indicating where the mud fluid was placed and the method or methods used in introducing it into the hole. If cement or other plugs were used, state the character of same and depth placed, from \_\_\_\_\_ feet to \_\_\_\_\_ feet for each plug set.

Plug off perfs at 5,860'.  
Mix 20 sks. cement. Plug at 5,650'.  
Put bridge at 900'.  
Pump 35 sks. cement at 900' to 800'.  
Fill with mud to 45'.  
Put 15 sks. cement at 45' to 0'.

RECEIVED  
STATE CORPORATION COMMISSION  
MAR 4 1970  
CONSERVATION DIVISION  
Wichita, Kansas

(If additional description is necessary, use BACK of this sheet)

Name of Plugging Contractor Sargent's Casing Pulling Service  
Address P. O. Box 506, Liberal, Kansas 67901

STATE OF KANSAS COUNTY OF SEWARD, ss.  
Chester A. Nordling (owner or operator) of the above-described

well, being first duly sworn on oath, says: That I have knowledge of the facts, statements, and matters herein contained and the log of the above-described well as filed and that the same are true and correct. So help me God

(Signature) Chester A. Nordling, Partner  
Liberal, Kansas (Address)



Subscribed and Sworn to before me this 16th day of February, 1970  
My Commission Expires Jan. 22, 1973  
Mary Ann Stoddard  
Notary Public.