

# COPY

# CONFIDENTIAL

SIDE ONE

STATE CORPORATION COMMISSION OF KANSAS  
 OIL & GAS CONSERVATION DIVISION  
 WELL COMPLETION FORM  
 ACO-1 WELL HISTORY  
 DESCRIPTION OF WELL AND LEASE

Operator: License # 4335

Name: TERROL ENERGY, INC.

Address 3245 BROADWAY

City/State/Zip BOULDER, CO. 80304

Purchaser: MOBIL NATURAL GAS

Operator Contact Person: TERRY D. ENRIGHT

Phone (303) 444-4545

Contractor: Name: BEREDCO, INC.

License: 5147

Wellsite Geologist: JACK HICKEY

Designate Type of Completion

New Well  Re-Entry  Workover

Oil  SWD  Temp. Abd.

Gas  Inj  Delayed Comp.

Dry  Other (Core, Water Supply, etc.)

If **OWWO**: old well info as follows:

Operator: \_\_\_\_\_

Well Name: \_\_\_\_\_

Comp. Date \_\_\_\_\_ Old Total Depth \_\_\_\_\_

Drilling Method:

Mud Rotary  Air Rotary  Cable

6/10/90 6/22/90 7/30/90

Spud Date Date Reached TD Completion Date

API NO. 15- 189 - 21,428-00-00

County STEVENS

NE NE NE Sec. 34 Twp. 33S Rge. 36 XX East West

4950 Ft. North from Southeast Corner of Section

330 Ft. West from Southeast Corner of Section  
(NOTE: Locate well in section plat below.)


Lease Name MORFORD Well # 1-34

Field Name WALKMEYER

Producing Formation LOWER MORROW

Elevation: Ground 3040 KB 3052.5

Total Depth 6600 PBDT 6252

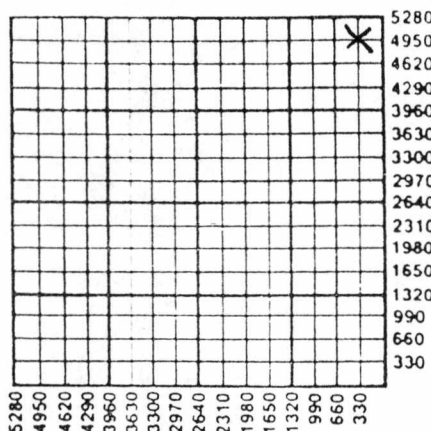

Amount of Surface Pipe Set and Cemented at 1732 Feet

Multiple Stage Cementing Collar Used?  Yes  No

If yes, show depth set 3285 Feet

If Alternate II completion, cement circulated from \_\_\_\_\_

feet depth to \_\_\_\_\_ w/ \_\_\_\_\_ sx cmt.

**INSTRUCTIONS:** This form shall be completed in triplicate and filed with the Kansas Corporation Commission, 200 Colorado Derby Building, Wichita, Kansas 67202, within 120 days of the spud date of any well. Rule 82-3-130, 82-3-107 and 82-3-106 apply. Information on side two of this form will be held confidential for a period of 12 months if requested in writing and submitted with the form. See rule 82-3-107 for confidentiality in excess of 12 months. One copy of all wireline logs and drillers time log shall be attached with this form. ALL CEMENTING TICKETS MUST BE ATTACHED. Submit CP-4 form with all plugged wells. Submit CP-111 form with all temporarily abandoned wells. Any recompletion, workover or conversion of a well requires filing of ACO-2 within 120 days from commencement date of such work.

All requirements of the statutes, rules and regulations promulgated to regulate the oil and gas industry have been fully complied with and the statements herein are complete and correct to the best of my knowledge.

Signature Terry D. Enright

Title PRESIDENT Date 11/12/90

Subscribed and sworn to before me this 12<sup>th</sup> day of November, 19 90.

Notary Public Roxanne E. [Signature]

Date Commission Expires 7-20-92

K.C.C. OFFICE USE ONLY		
F	<input checked="" type="checkbox"/>	Letter of Confidentiality Attached
C	<input checked="" type="checkbox"/>	Wireline Log Received
C	<input type="checkbox"/>	Drillers Timelog Received
Distribution		
<input checked="" type="checkbox"/>	KCC	<input type="checkbox"/> SWD/Rep <input type="checkbox"/> NGPA
<input type="checkbox"/>	KGS	<input type="checkbox"/> Plug <input type="checkbox"/> Other (Specify)

NOV 16 1990  
11-112-90