

This form shall be filed in duplicate with the Kansas Corporation Commission, 200 Colorado Derby Building, Wichita, Kansas 67202, within ten days after the completion of the well, regardless of how the well was completed.

Attach separate letter of request if the information is to be held confidential. If confidential, only file one copy. Information on side one will be of public record and side two will then be held confidential.

Circle one: Oil, Gas, Dry, SWD, OWWO, Injection. Type and complete ALL sections. Applications must be filed for dual completion, commingling, SWD and injection, T.A.

Attach wireline logs (i.e. electrical log, sonic log, gamma ray neutron log, etc.). KCC # (316) 263-3238. (Rules 82-2-105 & 82-2-125)

OPERATOR Quingue Operating Company

API NO. 15-175-20,664 ²⁰⁶²²⁻⁰⁰⁻⁰¹

ADDRESS 18 W. Third St.

COUNTY Seward

Liberal, KS 67901

FIELD Wildcat EVALYN-CONDIT, N.E.

**CONTACT PERSON Sharon Freeman

PROD. FORMATION Upper Morrow

PHONE 316-624-2578

LEASE Adeline (re-entry of Funk Adeline #1-22)

PURCHASER waiting on pipeline conn

WELL NO. #1-22

ADDRESS _____

WELL LOCATION C NW NE

DRILLING NRG Drilling

660 Ft. from North Line and

CONTRACTOR _____


1980 Ft. from East Line of

ADDRESS 326 N. Lincoln

the NE SEC. 22 TWP. 34S RGE. 32W

Liberal, KS 67901

WELL PLAT

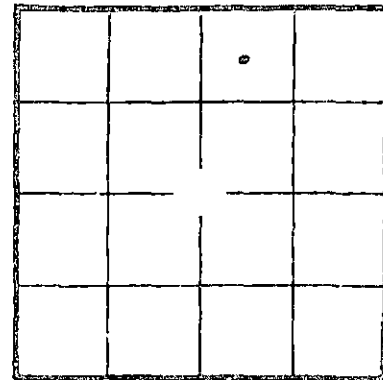

KCC
KGS
(Office Use)

PLUGGING _____

CONTRACTOR _____

ADDRESS _____

TOTAL DEPTH 6550' PBTD _____

Re-entry on

SPUD DATE 8/24/82 DATE COMPLETED 9/29/82

ELEV: GR 2742 DF 2752 KB 2753

DRILLED WITH (CABLE) (ROTARY) (AIR) TOOLS

Amount of surface pipe set and cemented 1200' set by Funk . DV Tool Used? _____

A F F I D A V I T

STATE OF Kansas, COUNTY OF Seward SS, I, _____

Sharon Freeman OF LAWFUL AGE, BEING FIRST DULY SWORN UPON HIS OATH,

DEPOSES THAT HE IS Coordinator (FOR)(OF) Quingue Operating Company

OPERATOR OF THE Adeline #1-22 LEASE, AND IS DULY AUTHORIZED TO MAKE

THIS AFFIDAVIT FOR AND ON THE BEHALF OF SAID OPERATOR, THAT WELL NO. 1-22 ON

SAID LEASE HAS BEEN COMPLETED AS OF THE 29th DAY OF September, 19 82, AND THAT

ALL INFORMATION ENTERED HEREIN WITH RESPECT TO SAID WELL IS TRUE AND CORRECT.

FURTHER AFFIANT SAITH NOT.

This needs to be signed on original

(S) _____

LARISSA JOHNS

SUBSCRIBED AND SWORN BEFORE ME THIS 8 DAY OF Nov, 19 82.

My Commission Expires: _____

10-22-84

MY COMMISSION EXPIRES: 10-22-84

RECEIVED
NOTARY PUBLIC STATE CORPORATION COMMISSION

NOV 10 1982

**The person who can be reached by phone regarding any questions concerning this information. Within 45 days of completion, a witnessed initial test by _____ Commission is required if the well produces more than 25 BOFPD or is located in a Basin of Public Interest.