

STATE CORPORATION COMMISSION OF KANSAS
OIL & GAS CONSERVATION DIVISION

WELL COMPLETION OR RECOMPLETION FORM
ACO-1 WELL HISTORY

DESCRIPTION OF WELL AND LEASE

Operator: License # 5652
Name Mustang Drilling & Exploration, Inc
Address P.O. Box 1609
Great Bend, Kansas 67530
City/State/Zip

Purchaser

Operator Contact Person J.P. Meroney
Phone 316-792-7323

Contractor: License # 5652
Name Mustang Drilling & Exploration, Inc.

Wellsite Geologist Gary Holstin
Phone 316-788-4570

Designate Type of Completion

- New Well Re-Entry Workover
- Oil SWD Temp Abd
- Gas Inj Delayed Comp.
- Dry Other (Core, Water Supply etc.)

If ONWO: old well info as follows:

Operator
Well Name
Comp. Date Old Total Depth

WELL HISTORY

Drilling Method:

- Mud Rotary Air Rotary Cable

1-14-86 1-24-86 1-24-86
Spud Date Date Reached TD Completion Date
5892' PBT
Total Depth

Amount of Surface Pipe Set and Cemented at 1518' feet
Multiple Stage Cementing Collar Used? Yes No
If yes, show depth set... feet
If alternate 2 completion, cement circulated from... feet depth to... w/... SX cmt

API NO. 15-119-20-740-00-00
County Meade
C NE SW Sec 7 Twp 33S Rge 29W East West

1980 Ft North from Southeast Corner of Section
3300 Ft West from Southeast Corner of Section
(Note: Locate well in section plat below)


Lease Name Fink Well # 1-7

Field Name

Producing Formation

Elevation: Ground 2704' KB 2714'

Section Plat

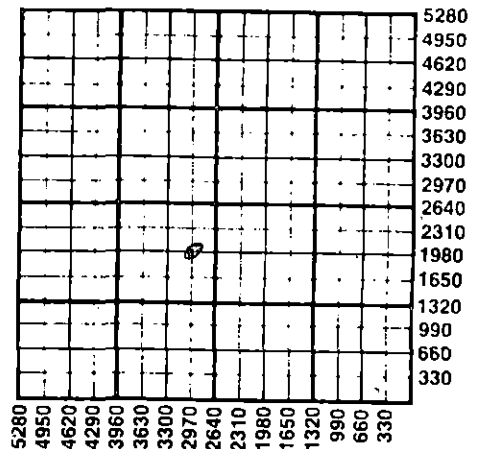

WATER SUPPLY INFORMATION

Disposition of Produced Water: Disposal Repressuring
Docket #

Questions on this portion of the ACO-1 call:
Water Resources Board (913) 296-3717

Source of Water: T-86-39
Division of Water Resources Permit #

Groundwater 4950 Ft North from Southeast Corner
(Well) 2970 Ft West from Southeast Corner of
Sec Twp Rge East West
7 33S 29W

Surface Water... Ft North from Southeast Corner
(Stream, pond etc)... Ft West from Southeast Corner
Sec Twp Rge East West

Other (explain)...
(purchased from city, R.W.D. #)

INSTRUCTIONS: This form shall be completed in duplicate and filed with the Kansas Corporation Commission, 200 Colorado Derby Building, Wichita, Kansas 67202, within 90 days after completion or recompletion of any well. Rule 82-3-130 and 82-3-107 apply. Information on side two of this form will be held confidential for a period of 12 months if requested in writing and submitted with the form. See rule 82-3-107 for confidentiality in excess of 12 months. One copy of all wireline logs and drillers time log shall be attached with this form. Submit CP-4 form with all plugged wells. Submit CP-111 form with all temporarily abandoned wells.

All requirements of the statutes, rules and regulations promulgated to regulate the oil and gas industry have been fully complied with and the statements herein are complete and correct to the best of my knowledge.

Signature [Signature] Title Exploration Manager Date 2-11-86

Subscribed and sworn to before me this 11 day of February 1986 Notary Public [Signature]

Date Commission Expires [Signature] DARDENE V. WATTS NOTARY PUBLIC STATE OF KANSAS

K.C.C. OFFICE USE ONLY
F Letter of Confidentiality Attached
C Wireline Log Received
C Drillers Timelog Received
Distribution
 KCC SWD/Rep NGPA
 KGS Plug Other
(Specify)

RECEIVED STATE CORPORATION COMMISSION FEB 11 1986 2-11-1986 CONSERVATION DIVISION Wichita, Kansas

Sec. 7, Twp. 33Rge. 29W

SIDE TWO

Operator Name Mustang Drilling & Exploration, Inc. Lease Name Fink Well # 1-7

Sec. 7 Twp. 33S Rge. 29W East West County Meade

WELL LOG

INSTRUCTIONS: Show important tops and base of formations penetrated. Detail all cores. Report all drill stem tests giving interval tested, time tool open and closed, flowing and shut-in pressures, whether shut-in pressure reached static level, hydrostatic pressures, bottom hole temperature, fluid recovery, and flow rates if gas to surface during test. Attach extra sheet if more space is needed. Attach copy of log.

Drill Stem Tests Taken Yes No
 Samples Sent to Geological Survey Yes No
 Cores Taken Yes No

Formation Description
 Log Sample

DST #1 5737-5798, times 30-45-60-60,
 IF 72-72
 ISIP 94
 IHP 2886
 FF 65-65
 FSIP 72
 FHP 2774
 REC: 15' mud.
 1st open weak surging blow
 2nd open no blow

Name	Top	Bottom
Heebner	4470	(-1756)
Toronto	4489	(-1775)
Lansing	4612	(-1898)
Base Kansas City	5236	(-2522)
Marmaton	5276	(-2562)
Altamont	5326	(-2612)
Pawnee	5376	(-2662)
Ft. Scott	5422	(-2708)
Morrow Shale	5736	(-3022)
Mississippi	5814	(-3100)

CASING RECORD <input checked="" type="checkbox"/> New <input type="checkbox"/> Used							
Report all strings set-conductor, surface, intermediate, production, etc.							
Purpose of String	Size Hole Drilled	Size Casing Set (in O.D.)	Weight Lbs/Ft.	Setting Depth	Type of Cement	#Sacks Used	Type and Percent Additives
Surface	12 1/4"	8 5/8"	24#	1518'	HCC	485	2% cc. floe seal
					C	125	2% cc
PERFORATION RECORD				Acid, Fracture, Shot, Cement Squeeze Record			
Shots Per Foot	Specify Footage of Each Interval Perforated			(Amount and Kind of Material Used)			Depth
TUBING RECORD				Liner Run <input type="checkbox"/> Yes <input type="checkbox"/> No			
Date of First Production	Producing Method <input type="checkbox"/> Flowing <input type="checkbox"/> Pumping <input type="checkbox"/> Gas Lift <input type="checkbox"/> Other (explain).....						
Estimated Production Per 24 Hours	Oil	Gas	Water	Gas-Oil Ratio	Gravity		
	Bbls	MCF	Bbls	CFPB			

METHOD OF COMPLETION

Production Interval

Disposition of gas: Vented Open Hole Perforation
 Sold Other (Specify)
 Used on Lease Dually Completed
 Commingled