

STATE CORPORATION COMMISSION OF KANSAS
OIL & GAS CONSERVATION DIVISION
WELL COMPLETION OR RECOMPLETION FORM
ACO-1 WELL HISTORY
DESCRIPTION OF WELL AND LEASE

Operator: License # 5181
Name Donald C. Slawson
Address Suite 700, 20 N. Broadway
City/State/Zip Oklahoma City, OK 73102

Purchaser Panhandle Eastern

Operator Contact Person Daniel G. Wilson
Phone (405) 232-0201

Contractor: License # 5181
Name Slawson Drilling Company

Wellsite Geologist Ed Heshner
Phone (806) 374-5256

Designate Type of Completion
 New Well Re-Entry Workover
 Oil SWD Temp Abd
 Gas Inj Delayed Comp.
 Dry Other (Core, Water Supply etc.)

If ~~OWN~~ old well, info as follows:
Operator
Well Name
Comp. Date Old Total Depth

WELL HISTORY

Drilling Method:
 Mud Rotary Air Rotary Cable
12/10/85 12/20/85 1/29/86
Spud Date Date Reached TD Completion Date
6,200' 6,140' (est.)
Total Depth PBTD

Amount of Surface Pipe Set and Cemented at 1557 feet
Multiple Stage Cementing Collar Used? Yes No
If yes, show depth set feet
If alternate 2 completion, cement circulated from feet depth to w/ SX cmt
Cement Company Name
Invoice #

API NO. 15-175-20,891-00-00
County Seward
C SE NW Sec. 21 Twp 34S Rge. 32 East West
3300 Ft North from Southeast Corner of Section
3300 Ft West from Southeast Corner of Section
(Note: Locate well in section plat below)


Lease Name STEFAN Well # 1-21

Field Name Wildcat Evalyn - Condit, East

Producing Formation Upper Morrow/Lower Morrow

Elevation: Ground 2763' KB 2769'

Section Plat

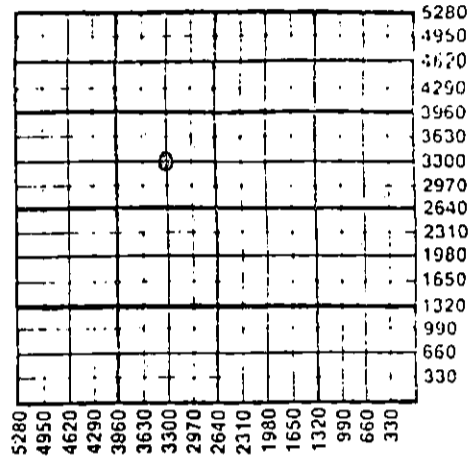

WATER SUPPLY INFORMATION

Disposition of Produced Water: Disposal
Docket # Repressuring

Questions on this portion of the ACO-1 call:
Water Resources Board (913) 296-3717

Source of Water:
Division of Water Resources Permit #

Groundwater Ft North from Southeast Corner (Well) Ft West from Southeast Corner of Sec Twp Rge East West

Surface Water Ft North from Southeast Corner (Stream, pond etc) Ft West from Southeast Corner Sec Twp Rge East West

Other (explain) (purchased from city, R.W.D. #)

INSTRUCTIONS: This form shall be completed in triplicate and filed with the Kansas Corporation Commission, 200 Colorado Derby Building, Wichita, Kansas 67202, within 120 days of the spud date of any well. Rule 82-3-130, 82-3-107 and 82-3-106 apply. Information on slide two of this form will be held confidential for a period of 12 months if requested in writing and submitted with the form. See rule 82-3-107 for confidentiality in excess of 12 months. One copy of all wireline logs and drillers time log shall be attached with this form. Submit CP-4 form with all plugged wells. Submit CP-111 form with all temporarily abandoned wells.

All requirements of the statutes, rules and regulations promulgated to regulate the oil and gas industry have been fully complied with and the statements herein are complete and correct to the best of my knowledge.

Signature Daniel G. Wilson
Title Division Engineer Date 10/19/87

Subscribed and sworn to before me this 19th day of October 1987
Notary Public Ginna L. Hawthorne
Date Commission Expires 5/7/88

K.C.C. OFFICE USE ONLY
 Letter of Confidentiality Attached
 Wireline Log Received
 Drillers Time Log Received
Distribution
 KCC SWD/Rep NGPA
 KGS Plug Other (Specify)

Sec. 34 Twp 34 Rge. 32

10-12-87