

STATE CORPORATION COMMISSION OF KANSAS
OIL & GAS CONSERVATION DIVISION

WELL COMPLETION OR RECOMPLETION FORM
ACO-1 WELL HISTORY

DESCRIPTION OF WELL AND LEASE

Operator: License # 4549
Name Anadarko Petroleum Corporation
Address Box 351
City/State/Zip Liberal, Kansas 67901

Purchaser: NA

Operator Contact Person Paul Gatlin
Phone (316) 624-6253

Contractor: License # 7860
Name Johnson Drilling Company, Inc.

Wellsite Geologist Ed Nichols
Phone (405) 652-2705

Designate Type of Completion
 New Well Re-Entry Workover
 Oil SWD Temp Abd
 Gas Inj Delayed Comp.
 Dry Other (Core, Water Supply etc.)

If ONWO: old well info as follows:
Operator
Well Name
Comp. Date Old Total Depth

WELL HISTORY

Drilling Method:
 Mud Rotary Air Rotary Cable
11/8/85 11/24/85 11/26/85
Spud Date Date Reached TD Completion Date
6500 Surface
Total Depth PBTD
Amount of Surface Pipe Set and Cemented at 1606 feet
Multiple Stage Cementing Collar Used? Yes No
If yes, show depth set feet
If alternate 2 completion, cement circulated from feet depth to w/SX cmt

API NO. 15-175-20,855-00-00

County Seward

C NE NE Sec. 1 Twp. 34S Rge. 33 East West

4620 Ft North from Southeast Corner of Section
660 Ft West from Southeast Corner of Section
(Note: Locate well in section plat below)


Lease Name Webb "C" Well # 1

Field Name Evalyn SE

Producing Formation

Elevation: Ground 2814 KB 2825

Section Plat

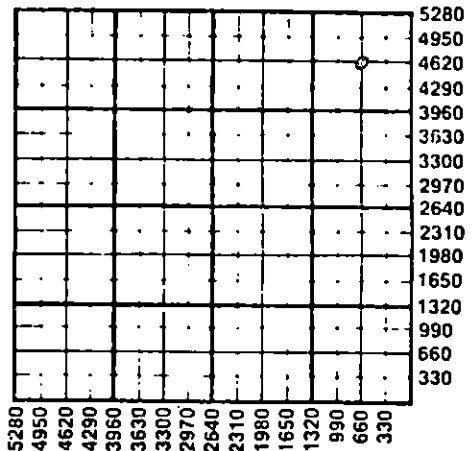

WATER SUPPLY INFORMATION

Disposition of Produced Water: Disposal Repressuring
Docket #

Questions on this portion of the ACO-1 call:

Water Resources Board (913) 296-3717

Source of Water:
Division of Water Resources Permit #

Groundwater.....Ft North from Southeast Corner (Well)Ft West from Southeast Corner of Sec Twp Rge East West

Surface Water.....Ft North from Southeast Corner (Stream, pond etc).....Ft West from Southeast Corner Sec Twp Rge East West

Other (explain) Drilling Contractor furnished water (purchased from city, R.W.D. #)


INSTRUCTIONS: This form shall be completed in duplicate and filed with the Kansas Corporation Commission, 200 Colorado Derby Building, Wichita, Kansas 67202, within 90 days after completion or recompletion of any well. Rule 82-3-130 and 82-3-107 apply. Information on side two of this form will be held confidential for a period of 12 months if requested in writing and submitted with the form. See rule 82-3-107 for confidentiality in excess of 12 months. One copy of all wireline logs and drillers time log shall be attached with this form. Submit CP-4 form with all plugged wells. Submit CP-111 form with all temporarily abandoned wells.

All requirements of the statutes, rules and regulations promulgated to regulate the oil and gas industry have been fully complied with and the statements herein are complete and correct to the best of my knowledge.

Signature Paul Campbell
Title Division Production Manager Date 12/11/85

Subscribed and sworn to before me this 12th day of December 1985

Notary Public Elizabeth J. Hooper
Date Commission Expires

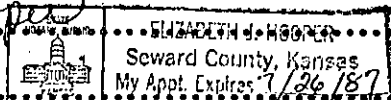

K.C.C. OFFICE USE ONLY
 Letter of Confidentiality Attached
 Wireline Log Received
 Drillers Time Log Received
 KCC SWD/Rep NGPA
 KGS Plug Other (Specify)

Sec. 1, Twp. 34S, Rge. 33W

DEC 16 1985

Operator Name Anadarko Petroleum Corporation Lease Name Webb "C" Well # 1

Sec. 1 Twp. 34S Rge. 33 East West County Seward

WELL LOG

INSTRUCTIONS: Show important tops and base of formations penetrated. Detail all cores. Report all drill stem tests giving interval tested, time tool open and closed, flowing and shut-in pressures, whether shut-in pressure reached static level, hydrostatic pressures, bottom hole temperature, fluid recovery, and flow rates if gas to surface during test. Attach extra sheet if more space is needed. Attach copy of log.

Drill Stem Tests Taken Yes No
 Samples Sent to Geological Survey Yes No
 Cores Taken Yes No

Formation Description
 Log Sample

Welex ran Spectral Density DSN Log and Dual Induction Guard Log.

Name	Top	Bottom
Surface, Clay & Sand	0'	380'
Sand & Redbed	380'	743'
Redbed & Shale	743'	933'
Glorieta Sand	933'	1213'
Shale	1213'	1595'
Anhydrite	1595'	1606'
Shale	1606'	2770'
Lime & Shale	2770'	6500'

CONFIDENTIAL

CASING RECORD <input checked="" type="checkbox"/> New <input type="checkbox"/> Used Report all strings set-conductor, surface, intermediate, production, etc.							
Purpose of String	Size Hole Drilled	Size Casing Set (In O.D.)	Weight Lbs/Ft.	Setting Depth	Type of Cement	#Sacks Used	Type and Percent Additives
Surface	12-1/4	8-5/8	24	1606	50/50 Port Common	600 200	2% CaCl 4% Gel 2% CaCl
PERFORATION RECORD				Acid, Fracture, Shot, Cement Squeeze Record			
Shots Per Foot	Specify Footage of Each Interval Perforated			(Amount and Kind of Material Used)			Depth
TUBING RECORD				Size	Set At	Packer at	Liner Run <input type="checkbox"/> Yes <input type="checkbox"/> No
Date of First Production	Producing Method <input type="checkbox"/> Flowing <input type="checkbox"/> Pumping <input type="checkbox"/> Gas Lift <input type="checkbox"/> Other (explain).....						
Estimated Production Per 24 Hours	Oil	Gas	Water	Gas-Oil Ratio	Gravity		
	Bbls	MCF	Bbls				

CFPB
RELEASED

METHOD OF COMPLETION

Production Interval

Disposition of gas: Vented Open Hole Perforation
 Sold Other (Specify)
 Used on Lease Dually Completed Commingled

MAR 22 1988
FROM CONFIDENTIAL

JOHNSON *Drilling Company, Inc.*



OFFICES IN
EVANSVILLE, INDIANA
TEL (812) 428-4911
OKLAHOMA CITY, OKLAHOMA
TEL (405) 943-7667

REPLY TO:

3535 N. W. 58th - Suite 710
Oklahoma City, Oklahoma 73112

CONFIDENTIAL

December 2, 1985

Anadarko Petroleum Corporation
P. O. Box 351
Liberal, Kansas 67901

Attn: Mr. Paul Gatlin

RECEIVED

DEC 4 1985

PRODUCTION DEPT.
LIBERAL, KANSAS

DRILLERS LOG for:

Webb "C" # 1
Section 1-34S-33W
Seward County, Kansas

0' - 380'
380' - 743'
743' - 933'
933' - 1213'
1213' - 1595'
1595' - 1606'
1606' - 2770'
2770' - 6500'

Surface, Clay, & Sand
Sand & Redbed
Redbed & Shale
Glorieta Sand
Shale
Anhydrite
Shale
Lime & Shale

DEC 2 n 1985
State Geological Survey
WICHITA BRANCH

JOHNSON DRILLING COMPANY, INC.

Signed by: Claude D. Moore
Claude D. Moore, Manager

STATE OF OKLAHOMA:

COUNTY OF OKLAHOMA:

Subscribed and sworn to before me this 2nd day of December, 1985.

Frank D. [Signature] Notary Public

My Commission Expires: 12-19-85

DEC 14 1985

RELEASED
MAR 22 1988
FROM CONFIDENTIAL