

COPY

CONFIDENTIAL

SIDE ONE

STATE CORPORATION COMMISSION OF KANSAS  
OIL & GAS CONSERVATION DIVISION  
WELL COMPLETION FORM  
ACO-1 WELL HISTORY  
DESCRIPTION OF WELL AND LEASE

Operator: License # 5003

Name: McCoy Petroleum Corporation

Address 110 S. Main, Suite 500

City/State/Zip Wichita KS 67202

Purchaser: Unknown

Operator Contact Person: Roger McCoy

Phone (316) 265-9697

Contractor: Name: Allen Drilling Co.

License: 5418

Wellsite Geologist: Tim Pierce STATE CORPORATION COMMISSION

Designate Type of Completion

New Well  Re-Entry  Workover

Oil  SWD  Temp. Abd.

Gas  Inj  Delayed Comp.

Dry  Other (Core, Water Supply, etc.)

If ~~OWHO~~ old well info as follows:

Operator: \_\_\_\_\_

Well Name: \_\_\_\_\_

Comp. Date \_\_\_\_\_ Old Total Depth \_\_\_\_\_

Drilling Method:

Mud Rotary  Air Rotary  Cable

11-14-90 11-25-90 2-16-91  
Spud Date Date Reached TD Completion Date

API NO. 15- 025-21,057-0000

County Clark

SE NW SE Sec. 34 Twp. 31S Rge. 21  East  West

1650  Ft. North from Southeast Corner of Section

1650  Ft. West from Southeast Corner of Section

(NOTE: Locate well in section plat below.)


Lease Name Harden "A"  Well # 1-34

Field Name Wildcat

Producing Formation Morrow Sand

Elevation: Ground 2013 KB 2018

Total Depth 5300' PBD \_\_\_\_\_

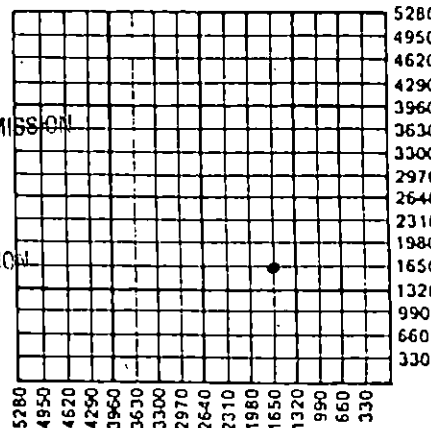

RECEIVED

APR 01 1991

CONSERVATION DIVISION  
Wichita, Kansas

Amount of Surface Pipe Set and Cemented at 685' Feet

Multiple Stage Cementing Collar Used?  Yes  No

If yes, show depth set \_\_\_\_\_ Feet

If Alternate II completion, cement circulated from \_\_\_\_\_

feet depth to \_\_\_\_\_ w/ \_\_\_\_\_ sx cmt.

INSTRUCTIONS: This form shall be completed in triplicate and filed with the Kansas Corporation Commission, 200 Colorado Derby Building, Wichita, Kansas 67202, within 120 days of the spud date of any well. Rule 82-3-130, 82-3-107 and 82-3-106 apply. Information on side two of this form will be held confidential for a period of 12 months if requested in writing and submitted with the form. See rule 82-3-107 for confidentiality in excess of 12 months. One copy of all wireline logs and drillers time log shall be attached with this form. ALL CEMENTING TICKETS MUST BE ATTACHED. Submit CP-4 form with all plugged wells. Submit CP-111 form with all temporarily abandoned wells. Any recompletion, workover or conversion of a well requires filing of ACO-2 within 120 days from commencement date of such work.

All requirements of the statutes, rules and regulations promulgated to regulate the oil and gas industry have been fully complied with and the statements herein are complete and correct to the best of my knowledge.

Signature [Signature]

Title President Date 3-28-91

Subscribed and sworn to before me this 28 day of March, 1991.

Notary Public [Signature]

Date Commission Expires January 5, 1992

K.C.C. OFFICE USE ONLY

F  Letter of Confidentiality Attached

C  Wireline Log Received

C  Drillers Timelog Received

Distribution

KCC  SWD/Rep  NGPA

KGS  Plug  Other (Specify)

91