

STATE OF KANSAS
STATE CORPORATION COMMISSION

Give All Information Completely
Make Required Affidavit
Mail or Deliver Report to:
Conservation Division
State Corporation Commission
212 North Market, Insurance Bldg.
Wichita, Kansas

WELL PLUGGING RECORD

Meade County, Sec. 16 Twp. 33S Rge. 28 (W)

Location as "NE/CNW/SW" or footage from lines 1,250' from south and west lines

Lease Owner The Shamrock Oil and Gas Corporation

Lease Name Fred Borchers Well No. 1

Office Address Box 631, Amarillo, Texas

Character of Well (completed as Oil, Gas or Dry Hole) Dry Hole

Date well completed October 2, 19 59

Application for plugging filed November 23, 19 59

Application for plugging approved November 30, 19 59


Plugging commenced December 10, 19 59

Plugging completed December 13, 19 59

Reason for abandonment of well or producing formation Excessive amount of water and no way to dispose of it economically.

If a producing well is abandoned, date of last production None 19

Was permission obtained from the Conservation Division or its agents before plugging was commenced? Yes

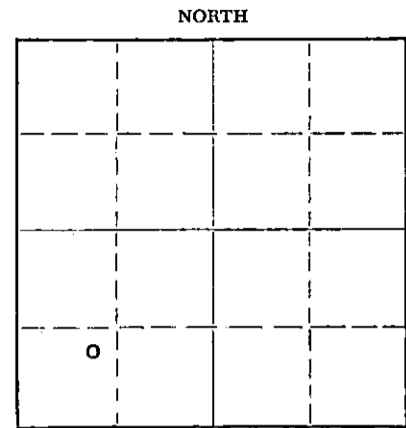

Locate well correctly on above Section Plat

Name of Conservation Agent who supervised plugging of this well W. L. Lackamp, Jr., Rt. 1, Stafford, Kansas

Producing formation None Depth to top Bottom Total Depth of Well 5840 Feet

Show depth and thickness of all water, oil and gas formations.

OIL, GAS OR WATER RECORDS

CASING RECORD

FORMATION	CONTENT	FROM	TO	SIZE	PUT IN	PULLED OUT
Sand & shale	Pos. Water	0	637	9 5/8"	1537.27	
				4 1/2"	5230.42	4795.98

Describe in detail the manner in which the well was plugged, indicating where the mud fluid was placed and the method or methods used in introducing it into the hole. If cement or other plugs were used, state the character of same and depth placed, from feet to feet for each plug set.

Shot 4 1/2" OD casing and pulled 4,795.98'. Mudded to 600' and spotted 25 sacks cement. Mudded up to 75' and spotted 10 sacks cement. Mudded up to 15' and spotted 5 sacks to base of cellar.

RECEIVED
STATE CORPORATION COMMISSION

DEC 18 1959

CONSERVATION DIVISION
Wichita, Kansas

(If additional description is necessary, use BACK of this sheet)

Name of Plugging Contractor Forbes Casing Pulling Unit

Address Great Bend, Kansas

STATE OF Texas COUNTY OF Potter, ss.
T. S. Clopton

(employee of owner) or (owner or operator) of the above-described well, being first duly sworn on oath, says: That I have knowledge of the facts, statements, and matters herein contained and the log of the above-described well as filed and that the same are true and correct. So help me God.

(Signature) T. S. Clopton

Box 631, Amarillo, Texas (Address)

SUBSCRIBED AND SWORN to before me this 16th day of December, 19 59

My commission expires 6-1-61

Potter County, Texas Notary Public.

FRED BORCHERS NO. 1
Section 16, Township 33 South, Range 28 West
Meade County, Kansas

Sand	0	132
Sand and shale	132	637
Red bed, shale, shells	637	995
Sand, shale, shells	995	1,275
Shale and shells	1,275	2,067
Shale	2,067	2,277
Lime and shale	2,277	3,307
Chalky lime & shale	3,307	3,429
Lime and shale	3,429	4,728
Lime	4,728	5,606
Morrow sand	5,606	5,658
Lime	5,658	5,840

RECEIVED
STATE CORPORATION COMMISSION
NOV 30 1959
CONSERVATION DIVISION
Wichita, Kansas