

STATE OF KANSAS  
STATE CORPORATION COMMISSION


Form CP-4

WELL PLUGGING RECORD

Give All Information Completely  
Make Required Affidavit  
Mail or Deliver Report to:  
Conservation Division  
State Corporation Commission  
211 No. Broadway  
Wichita, Kansas

Meade County, Sec. 15 Twp. 33S Rge. 28 (W)  
Location as "NE/CNW&SW&E" or footage from lines C SE/4 SE/4;  
Lease Owner Graham-Michaelis Drilling, Inc.  
Lease Name Isaac Well No. 1-15  
Office Address 211 North Broadway, Wichita, Kansas 67202  
Character of Well (completed as Oil, Gas or Dry Hole) Dry Hole  
Date well completed January 11, 1967  
Application for plugging filed January 11, 1967  
Application for plugging approved (verbal) January 11, 1967  
Plugging commenced January 11, 1967  
Plugging completed January 11, 1967  
Reason for abandonment of well or producing formation Dry Hole

NORTH

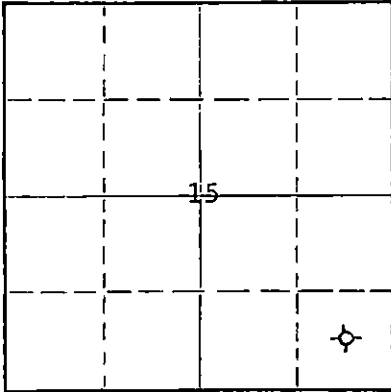

Locate well correctly on above  
Section Flat

If a producing well is abandoned, date of last production 19  
Was permission obtained from the Conservation Division or its agents before plugging was commenced? Yes (verbal)

Name of Conservation Agent who supervised plugging of this well Edgar J. Eves, Sublette  
Producing formation none Depth to top Bottom Total Depth of Well 6030' Feet  
Show depth and thickness of all water, oil and gas formations.

OIL, GAS OR WATER RECORDS

CASING RECORD

FORMATION	CONTENT	FROM	TO	SIZE	PUT IN	PULLED OUT
				8 5/8"	1466'	none

Describe in detail the manner in which the well was plugged, indicating where the mud fluid was placed and the method or methods used in introducing it into the hole. If cement or other plugs were used, state the character of same and depth placed, from feet to feet for each plug set.

Filled hole with heavy drilling mud, cement plug with 35 sacks cement at 700'.  
Continued filling hole with heavy drilling mud, cement plug with 15 sacks cement at 45' to surface.


RECEIVED  
STATE CORPORATION COMMISSION  
JAN 17 1967  
CONSERVATION DIVISION  
WICHITA, KANSAS

(If additional description is necessary, use BACK of this sheet)  
Name of Plugging Contractor Graham-Michaelis Drilling, Inc.  
Address 211 North Broadway, Wichita, Kansas 67202

STATE OF Kansas, COUNTY OF Sedgwick, ss.  
Jack L. Yinger (employee of owner) of the above-described well, being first duly sworn on oath, says: That I have knowledge of the facts, statements, and matters herein contained and the log of the above-described well as filed and that the same are true and correct. So help me God.

(Signature) Jack L. Yinger  
211 North Broadway, Wichita, Kansas 67202 (Address)

SUBSCRIBED AND SWORN TO before me this 13th day of January, 1967  
My commission expires December 12, 1970  
Evelyn D. Evans Notary Public.

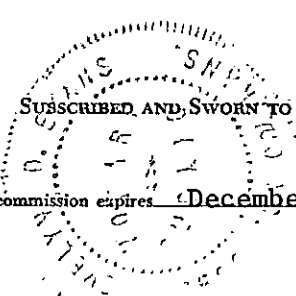

ISAAC NO. 1-15

WELL RECORD:

LOCATION:

SE/4 SE/4 Section 15-33S-28W  
Meade County, Kansas

Commenced: 12-27-66  
Completed: 1-11-67  
(Rotary)

CONTRACTOR:

Graham-Michaelis Drilling, Inc.  
Liberal Division  
P. O. Box 1294  
Liberal, Kansas 67901

CASING RECORD:

46 Joints 8-5/8" 24# Casing  
Cemented w/600 sx T.L.W. and  
w/200 sx Sunset

	<u>LOG</u>	
Surface Sand & Red Bed	0 -	540
Red Bed, Sand & Gyp	540 -	1861
Anhy, Shale & Gyp	1861 -	2210
Lime & Shale	2210 -	3600
Chalky Lime & Shale	3600 -	3841
Lime & Shale	3841 -	5785
Sand, Lime & Shale	5785 -	5816
Lime & Shale	5816 -	6030

6030' - Total Rotary Depth

RECEIVED  
STATE CORPORATION COMMISSION  
JAN 17 1967  
CONSERVATION DIVISION  
Wichita, Kansas

The undersigned, Graham-Michaelis Drilling, Inc., Liberal Division, certifies that the above log is a true and correct copy of the formations encountered in drilling the above mentioned well, as taken from the Daily Drilling Report.

GRAHAM-MICHAELIS DRILLING, INC.  
LIBERAL DIVISION

By H. R. Michaelis  
H. R. Michaelis