

15-119-00122-0000

STATE OF KANSAS
STATE CORPORATION COMMISSION

Give All Information Completely
Make Required Affidavit
Mail or Deliver Report to:
Conservation Division
State Corporation Commission
800 Bittig Building
Wichita, Kansas

WELL PLUGGING RECORD

Meade County, Sec. 15 Twp. 32 Rge. (E) 28 (W)

Location as "NE/CNW/SW" or footage from lines C NW SW

Lease Owner Herndon Drilling Company

Lease Name H. J. Isaac Well No. 1

Office Address Drawer 489, Tulsa, Oklahoma

Character of Well (completed as Oil, Gas or Dry Hole) Stuck Pipe

Date well completed 10-7-60 19 60

Application for plugging filed 10-7 19 60

Application for plugging approved 10-7 19 60

Plugging commenced 10-7 19 60


Plugging completed 10-7 19 60

Reason for abandonment of well or producing formation

Stuck Drill Pipe

If a producing well is abandoned, date of last production 19

Was permission obtained from the Conservation Division or its agents before plugging was commenced? Yes

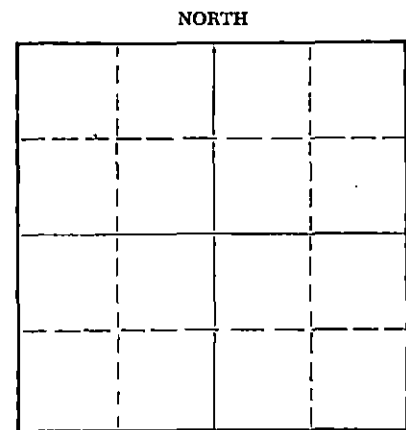

Locate well correctly on above Section Plat

Name of Conservation Agent who supervised plugging of this well Frank Broadfoot

Producing formation Depth to top Bottom Total Depth of Well 654 Feet

Show depth and thickness of all water, oil and gas formations.

OIL, GAS OR WATER RECORDS

CASING RECORD

FORMATION	CONTENT	FROM	TO	SIZE	PUT IN	PULLED OUT
					None	

Describe in detail the manner in which the well was plugged, indicating where the mud fluid was placed and the method or methods used in introducing it into the hole. If cement or other plugs were used, state the character of same and depth placed, from feet to feet for each plug set.

Run 120' drill pipe in hole; pumped cement thru drill pipe until filled to 3' of surface

NOV 7 1960
11-17-60

Name of Plugging Contractor Herndon Drilling Company (If additional description is necessary, use BACK of this sheet)
Address Drawer 489, Tulsa, Oklahoma

STATE OF OKLAHOMA, COUNTY OF TULSA, ss.
W. G. Prather (employee of owner) or (owner or operator) of the above-described

well, being first duly sworn on oath, says: That I have knowledge of the facts, statements, and matters herein contained and the log of the above-described well as filed and that the same are true and correct. So help me God.

(Signature) W. G. Prather

Lyons, Kansas (Address)

SUBSCRIBED AND SWORN TO before me this 7th day of November, 19 60

My commission expires June 19, 1961

Johnnie Alene Frese Notary Public

WELL LOG

Well: ISAAC NO. 1
 Location: C NW SW, Section 15-33S-28W,
 Meade County, Kansas
 Owner: Herndon Drilling Company

Spudding date: 10-5-60
 Date casing set: 10-10-60
 Date rotary completed: 11-3-60
 Date cable completed:

FROM	TO	FORMATION	REMARKS
0	654	Surface Hole	Drill pipe stuck @ 550'. Plugged hole with Halliburton thru drill pipe. Filled hole with cement from 100' to cellar. Skidded rig.
0	40	Surface Hole	
40	65	Clay	
65	205	Sand	
205	560	Red Bed & Gyp. Strks.	
560	1020	Shale	
1020	1085	Shale and Shells	
1085	1300	Red Bed & Gyp.	
1300	1451	Shale and Lime	Ran 47 joints 8-5/8" 24# J-5 Lone Star new pipe. Set @ 1450'. Cemented w/60 sx.
1451	1485	Anhydrite	Common, 2% Gel. 290 sx. Common, 1% CC.
1485	1925	Red Bed, Shale & Shells	250 sx. Common, 2% CC. and 200 sx.
1925	1960	Anhydrite and Shale	Sunset.
1960	2585	Lime and Shale	
2585	3175	Lime	
3175	3355	Lime with Chalk Strks.	
3355	3550	Lime and Chalk	
3550	3725	Lime	
3725	4480	Lime and Shale	
4480	5746	Lime	
5746	5814	Sand and Lime	
5814	6020	Lime	
	6020	Total Depth	Plugged hole. Set bridge @ 600'. Cemented w/40 sacks. Set bridge @ 35' cemented w/10 sx. Plugged hole w/Sun Oil Well Cementing Company.

[Faint, illegible stamp or handwritten notes]

Subscribed and sworn to before me this 16th
 day of November, 19 60

I certify the above and foregoing to be a true and exact copy
 of the original driller's log on the ISAAC NO. 1

Johnnie Allen Fese
 Notary Public
 My commission expires:
 June 19, 1961

HERNDON DRILLING COMPANY

By: *C. T. Moore*
 Title: C. T. Moore, Asst. Secty.