

15-119-30079-0000


STATE OF KANSAS  
STATE CORPORATION COMMISSION

Form CP-4

Give All Information Completely  
Make Required Affidavit  
Mail or Deliver Report to:  
Conservation Division  
State Corporation Commission  
211 No. Broadway  
Wichita, Kansas

WELL PLUGGING RECORD

NORTH

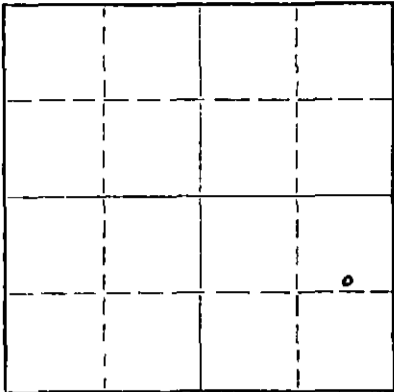

Locate well correctly on above  
Section Plat

Meade County, Sec. 18 Twp. 33S Rge. (E) 28 (W)  
Location as "NE/CNW/SW" or footage from lines. Approx. C-E/2 SE/4  
Lease Owner Petroleum Inc.  
Lease Name Roberts "E" Well No. 1  
Office Address P.O. Box 1255, Liberal, Kansas  
Character of Well (completed as Oil, Gas or Dry Hole) Dry Hole  
Date well completed 1-9 19 66  
Application for plugging filed 1-10 19 66  
Application for plugging approved 1-11 19 66  
Plugging commenced 1-9 19 66  
Plugging completed 1-9 19 66  
Reason for abandonment of well or producing formation \_\_\_\_\_

If a producing well is abandoned, date of last production \_\_\_\_\_ 19 \_\_\_\_  
Was permission obtained from the Conservation Division or its agents before plugging was commenced? Yes

Name of Conservation Agent who supervised plugging of this well Hugh Scott  
Producing formation None Depth to top \_\_\_\_\_ Bottom \_\_\_\_\_ Total Depth of Well 5825' Feet  
Show depth and thickness of all water, oil and gas formations.

OIL, GAS OR WATER RECORDS

CASING RECORD

FORMATION	CONTENT	FROM	TO	SIZE	PUT IN	PULLED OUT
None				8-5/8"	1320'	None

Describe in detail the manner in which the well was plugged, indicating where the mud fluid was placed and the method or methods used in introducing it into the hole. If cement or other plugs were used, state the character of same and depth placed, from \_\_\_\_\_ feet to \_\_\_\_\_ feet for each plug set.

Filled hole with heavy mud from 5825' to 700' followed by 35 sacks cement to 600'.  
Filled hole with heavy mud from 600' to 45' followed by 15 sacks cement to base of well cellar.

STATE CORPORATION COMMISSION  
WICHITA, KANSAS  
JAN 17 1966  
CONSERVATION DIVISION  
WICHITA, KANSAS

(If additional description is necessary, use BACK of this sheet)  
Name of Plugging Contractor Garvey Drilling Co.  
Address R.R. # 2 Great Bend, Kansas

STATE OF Kansas, COUNTY OF Seward, ss.  
Harold L. Young (employee of owner) or (owner or operator) of the above-described well, being first duly sworn on oath, says: That I have knowledge of the facts, statements, and matters herein contained and the log of the above-described well as filed and that the same are true and correct. So help me God.

(Signature) Harold L. Young  
P.O. Box 1255 Liberal, Kansas  
(Address)

SUBSCRIBED AND SWORN TO before me this 14th day of January, 19 66  
Richard D. Funk  
Notary Public.

My commission expires January 20, 1969

15-119-30079-0000

# WELL LOG

COMPANY Petroleum, Inc.

SEC. 18 T. 33S R. 28W

FARM Roberts Unit

NO. 1

LOC. NE SE


TOTAL DEPTH 5825'

COUNTY Meade

COMM. 12-22-65

COMP. 1-9-66

CONTRACTOR Garvey Drilling Company

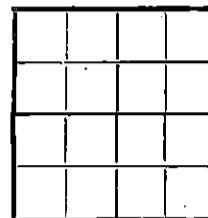

CASING 8 5/8" @ 1320' w/650 sx

ELEVATION

PRODUCTION D & A

FIGURES INDICATE BOTTOM OF FORMATIONS

250' Sand and Clay  
 380' Red Bed  
 1095' Sand and Red Bed  
 1334' Red Bed and Sand  
 1549' Shale and Clay  
 1880' Shale  
 2168' Shale and Shells  
 2348' Shale  
 2433' Shale and Lime  
 2694' Lime and Shale  
 2707' Lime  
 2857' Shale and Lime  
 3389' Lime and Shale  
 3776' Shale and Lime  
 3915' Lime and Shale  
 4115' Shale and Lime  
 4323' Lime and Shale  
 4475' Shale and Lime  
 4696' Lime and Shale  
 4818' Lime  
 4925' Lime and Shale  
 5040' Lime  
 5115' Lime and Shale  
 5825' Lime  
 5825' RTD

RECEIVED  
 STATE CORPORATION COMMISSION  
 JAN 17 1966  
 CONSERVATION DIVISION  
 Wichita, Kansas

State of Kansas }  
 County of Barton } SS

I, Sam N. Stephens of Garvey Drilling Company

upon oath state the above and foregoing is a true and correct copy of the log of the Roberts E-1 well.

*Sam N. Stephens*

Subscribed and sworn to before me this 13th day of January 19 66

My Commission Expires: November 5, 1969

*Richard S. Boyd*  
 NOTARY PUBLIC