


STATE OF KANSAS  
STATE CORPORATION COMMISSION

WELL PLUGGING RECORD

Give All Information Completely  
Make Required Affidavit  
Mail or Deliver Report to  
Conservation Division  
State Corporation Comm.  
245 North Water  
Wichita, KS 67202

Meade County, Sec. 19 Twp. 33S Rge. 28W E/W  
Location as "NE/CNW $\frac{1}{4}$ SW $\frac{1}{4}$ " or footage from lines  
1450'FWL 330'FSL NW $\frac{1}{4}$   
Lease Owner Diamond Shamrock Corporation  
Lease Name Harvey C. Feldman Well No. 3  
Office Address Rt. 1 Box 23 Canadian, Texas 79014  
Character of Well (Completed as Oil, Gas or Dry Hole)  
Dry Hole  
Date Well completed 9-20-80 19  
Application for plugging filed 9-17 19 80  
Application for plugging approved 9-18 19 80  
Plugging commenced 9-17 19 80  
Plugging completed 9-20 19 80  
Reason for abandonment of well or producing formation

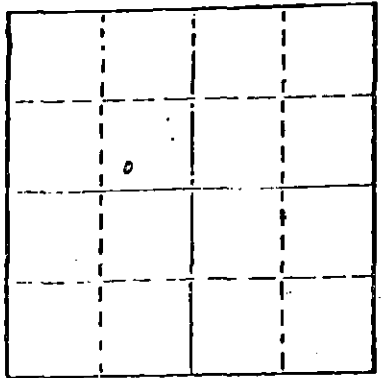

Locate well correctly on above  
Section Plat

If a producing well is abandoned, date of last production 19

Was permission obtained from the Conservation Division or its agents before plugging was commenced? Yes

Name of Conservation Agent who supervised plugging of this well Clarence Thomas  
Producing formation Depth to top Bottom Total Depth of Well 5789  
Show depth and thickness of all water, oil and gas formations.

OIL, GAS OR WATER RECORDS

CASING RECORD

FORMATION	CONTENT	FROM	TO	SIZE	PUT IN	PULLED OUT
				8 5/8	1626	none
				5 1/2	5774	3520

Describe in detail the manner in which the well was plugged, indicating where the mud fluid was placed and the method or methods used in introducing it into the hold. If cement or other plugs were used, state the character of same and depth placed, from feet to feet for each plug set.

Pump 20 sks. of cement from 5728 to 5300  
Pump 35 sks. of cement from 1650 to 1550  
Pump 25 sks. of cement from 750 to 650  
Put 10 sks. of cement from 40 to 0  
Cut off & cap 8 5/8 3' below ground level

RECEIVED  
STATE CORPORATION COMMISSION  
OCT 23 1980  
CONSERVATION DIVISION  
Wichita, Kansas

(If additional description is necessary, use BACK of this sheet)

Name of Plugging Contractor Sargents Casing Pulling Ser. Box 506 Liberal, Kansas 67901 Ks. No. 511

STATE OF Texas COUNTY OF Potter, ss.  
Gene Sparks (employee of owner) xxxxxxxxxxxxxxxxxxxx  
of the above-described well, being first duly sworn on oath, says: That I have knowledge of the facts, statements, and matters herein contained and the log of the above-described well as filed and that the same are true and correct. So Help me God.  
(Signature) Gene Sparks  
P. O. Box 631, Amarillo, Texas 79173  
(Address)

SUBSCRIBED AND SWORN TO before me this 21st day of October, 19 80

Peggy B. Rogers  
Notary Public.

My commission expires 4-20-84