

15-119-20422-0000

STATE OF KANSAS
STATE CORPORATION COMMISSION

WELL PLUGGING RECORD

Give All Information Completely
Make Required Affidavit
Mail or Deliver Report to:
Conservation Division
State Corporation Commission
212 North Market, Insurance Bldg.
Wichita, Kansas

Meade County. Sec. 19 Twp. 33S Rge. 28 (W)

Location as "NE/CNWxSWx" or footage from lines 660' FSL & 1780' FEL

Lease Owner Diamond Shamrock Corporation

Lease Name Jacob J. Reimer Well No. 1

Office Address P. O. Box 631, Amarillo, TX 79173

Character of Well (completed as Oil, Gas or Dry Hole) Dry

Date well completed August 26 19 80

Application for plugging filed October 14, 19 80

Application for plugging approved Verbal August 25 19 80


Plugging commenced August 26 19 80

Plugging completed August 26, 19 80

Reason for abandonment of well or producing formation

If a producing well is abandoned, date of last production 19

Was permission obtained from the Conservation Division or its agents before plugging was commenced? yes

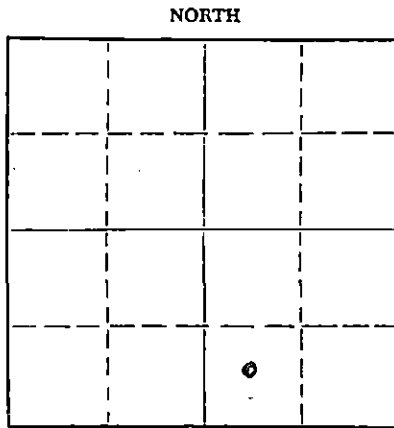

Locate well correctly on above Section Plat

Name of Conservation Agent who supervised plugging of this well Mr. Thomas

Producing formation Depth to top Bottom Total Depth of Well 5790 Feet

Show depth and thickness of all water, oil and gas formations.

OIL, GAS OR WATER RECORDS

CASING RECORD

FORMATION	CONTENT	FROM	TO	SIZE	PUT IN	PULLED OUT
				8 5/8	1617	0

Describe in detail the manner in which the well was plugged, indicating where the mud fluid was placed and the method or methods used in introducing it into the hole. If cement or other plugs were used, state the character of same and depth placed, from feet to feet for each plug set.

Pumped 60 sx Class H cmt @ 1600' displaced with 18 bbls. water

Pumped 25 sx Class H cmt. @ 814' displaced with 9 bbls. water

Pumped 10 sx Class H cmt. @ 40'-0.

RECEIVED
STATE CORPORATION COMMISSION

OCT 21 1980
10-21-80
CONSERVATION DIVISION
Wichita, Kansas

(If additional description is necessary, use BACK of this sheet)

Name of Plugging Contractor Halliburton Services

Address Liberal, Kansas

STATE OF Texas COUNTY OF Potter, ss.

Stuard Byram (employee of owner) or (owner or operator) of the above-described

well, being first duly sworn on oath, says: That I have knowledge of the facts, statements, and matters herein contained and the log of the above-described well as filed and that the same are true and correct. So help me God.

(Signature) Stuard Byram

P. O. Box 631, Amarillo, TX 79173 (Address)

SUBSCRIBED AND SWORN to before me this 16th day of October, 19 80

Notary Public... (Signature) Peggy B. Rogers

My commission expires 4-20-84