


STATE OF KANSAS
STATE CORPORATION COMMISSION

Give All Information Completely
Make Required Affidavit
Mail or Deliver Report to:
Conservation Division
State Corporation Commission
212 North Market, Insurance Bldg.
Wichita, Kansas

WELL PLUGGING RECORD

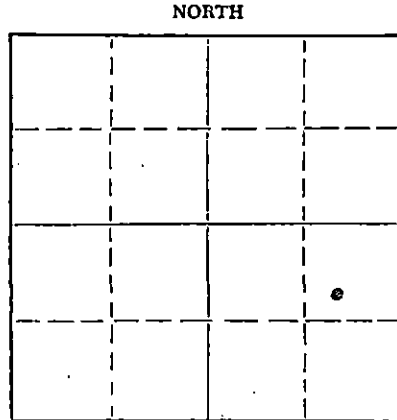

Locate well correctly on above
Section Plat

Meade County. Sec. 19 Twp. 33S Rge. (E) 28 (W)
Location as "NE/CNW/SW" or footage from lines. 1650' FSL, 990' FEL
Lease Owner Jacob J. Reimer
Lease Name Jacob Reimer Well No. 2
Office Address P. O. Box 631, Amarillo, Texas 79173
Character of Well (completed as Oil, Gas or Dry Hole) Dry Hole
Date well completed 8-21-81 19
Application for plugging filed 9-25-81 19
Application for plugging approved 19
Plugging commenced 10-19-81 19
Plugging completed 10-21-81 19
Reason for abandonment of well or producing formation Dry Hole

If a producing well is abandoned, date of last production 19
Was permission obtained from the Conservation Division or its agents before plugging was commenced? Yes

Name of Conservation Agent who supervised plugging of this well Paul Luthl
Producing formation Depth to top Bottom Total Depth of Well 5814 Feet
Show depth and thickness of all water, oil and gas formations.

OIL, GAS OR WATER RECORDS

CASING RECORD

FORMATION	CONTENT	FROM	TO	SIZE	PUT IN	PULLED OUT
				8-5/8	1734	0
				5-1/2	5283	3321
				2-3/8	5014	5014

Describe in detail the manner in which the well was plugged, indicating where the mud fluid was placed and the method or methods used in introducing it into the hole. If cement or other plugs were used, state the character of same and depth placed, from feet to feet for each plug set.

CIBP - 5100' w/2 sxs cmt.
Plug #1 - 1700' to 1600' w/50 sxs Class "H"
Plug #2 - 33' to 3' w/10 sxs Class "H"

RECEIVED
STATE CORPORATION COMMISSION
NOV 9 1981
CONSERVATION DIVISION
Wichita, Kansas

(If additional description is necessary, use BACK of this sheet)
Name of Plugging Contractor Sargents Casing Pullers
Address Box 506, Liberal, Kansas 67901

STATE OF Texas, COUNTY OF Potter, SS.
Diamond Shamrock Corporation (employee of owner) or (owner or operator) of the above-described well, being first duly sworn on oath, says: That I have knowledge of the facts, statements, and matters herein contained and the log of the above-described well as filed and that the same are true and correct. So help me God.

(Signature) Kent Kirkpatrick
P. O. Box 631, Amarillo, Texas 79173
(Address)

SUBSCRIBED AND SWORN TO before me this 4th day of November, 19 81

My commission expires 5-06-85 Notary Public.