


15-119-00094-0000

STATE OF KANSAS  
STATE CORPORATION COMMISSION

WELL PLUGGING RECORD

Give All Information Completely  
Make Required Affidavit  
Mail or Deliver Report to:  
Conservation Division  
State Corporation Commission  
212 North Market, Insurance Bldg.  
Wichita, Kansas

Meade County. Sec. 20 Twp 33S Rge. 28 ~~NE~~ X (W)  
Location as "NE/CNW/SW" or footage from lines 660' from South and West  
Lease Owner The Shamrock Oil and Gas Corporation  
Lease Name George Roberts Well No. 1  
Office Address Box 631, Amarillo, Texas  
Character of Well (completed as Oil, Gas or Dry Hole) Dry Hole  
Date well completed May 11, 19 59  
Application for plugging filed May 11, 19 59  
Application for plugging approved May 13, 19 59  
Plugging commenced May 13, 19 59  
Plugging completed May 13, 19 59  
Reason for abandonment of well or producing formation Dry

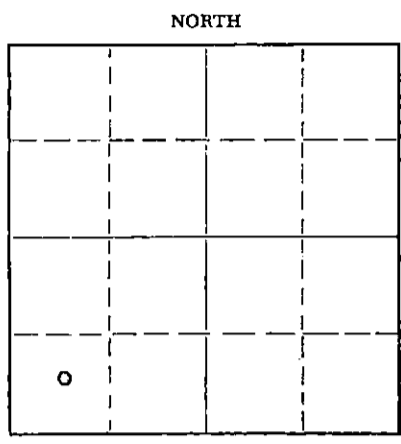

Locate well correctly on above  
Section Plat

If a producing well is abandoned, date of last production \_\_\_\_\_ 19 \_\_\_\_  
Was permission obtained from the Conservation Division or its agents before plugging was commenced? Yes

Name of Conservation Agent who supervised plugging of this well Merle Rives - Garden City, Kansas  
Producing formation None Depth to top \_\_\_\_\_ Bottom \_\_\_\_\_ Total Depth of Well 5,832 Feet  
Show depth and thickness of all water, oil and gas formations.

OIL, GAS OR WATER RECORDS

CASING RECORD

FORMATION	CONTENT	FRDM	TD	SIZE	PUT IN	PULLED OUT
Surface and sand	Pos. Water	0	606	9 5/8"	1,561	-0-

Describe in detail the manner in which the well was plugged, indicating where the mud fluid was placed and the method or methods used in introducing it into the hole. If cement or other plugs were used, state the character of same and depth placed, from \_\_\_\_\_ feet to \_\_\_\_\_ feet for each plug set.

Filled hole with rotary mud and pushed 9 5/8" Halliburton plug to 600'. Spotted 25 sacks cement. Filled top of hole with rotary mud and pushed second Halliburton plug to 37'. Spotted 17 sacks cement on top of plug.

RECEIVED  
STATE CORPORATION COMMISSION  
MAY 18 1959  
CONSERVATION DIVISION  
WICHITA, KANSAS

(If additional description is necessary, use BACK of this sheet)  
Name of Plugging Contractor Halliburton Oil Well Cementing Company  
Address Liberal, Kansas

STATE OF TEXAS, COUNTY OF POTTER, ss.  
Dan P. Long (employee of owner) or (~~owner or operator~~) of the above-described well, being first duly sworn on oath, says: That I have knowledge of the facts, statements, and matters herein contained and the log of the above-described well as filed and that the same are true and correct. So help me God.

(Signature) Dan P. Long  
Box 631, Amarillo, Texas (Address)

SUBSCRIBED AND SWORN TO before me this 15th day of May 19 59

Juline Howell  
Potter County, Texas Notary Public.

My commission expires 6-1-61

PLUGGING  
FILE SEC. 20 T. 33 R. 28  
BOOK PAGE 39 LINE 15

GEORGE ROBERTS NO. 1  
 Section 20, Township 33 South, Range 28 West  
 Meade County, Kansas

0'	-	1,327'	Sand & red beds
1,327'	-	1,863'	Red bed & shells
1,863'	-	2,425'	Shale & lime
2,425'	-	2,710'	Dolomite & chat
2,710'	-	2,730'	Shale
2,730'	-	3,020'	Lime
3,020'	-	3,035'	Shale
3,036'	-	3,170'	Lime
3,170'	-	3,180'	Shale
3,180'	-	3,240'	Lime
3,240'	-	3,250'	Shale
3,250'	-	3,335'	Lime
3,335'	-	3,340'	Shale
3,340'	-	3,410'	Lime
3,410'	-	3,420'	Shale
3,420'	-	3,735'	Lime
3,735'	-	3,920'	Shale
3,920'	-	3,935'	Lime
3,935'	-	4,275'	Shale
4,275'	-	4,390'	Lime
4,390'	-	4,530'	Shale & lime
4,530'	-	4,710'	Lime
4,710'	-	4,730'	Shale
4,730'	-	5,020'	Lime
5,020'	-	5,075'	Shale w/ lime streaks
5,075'	-	5,270'	Lime w/ shale streaks
5,270'	-	5,280'	Shale
5,280'	-	5,470'	Lime & shale
5,470'	-	5,490'	Sand & shale
5,490'	-	5,578'	Shale & lime
5,578'	-	5,580'	Sand
5,580'	-	5,832'	Shale & lime.

RECEIVED  
 STATE CORPORATION COMMISSION  
 MAY 18 1959  
 CONSERVATION DIVISION  
 WICHITA

PLUGGING  
 FILE SEC. 20 T. 33 R. 28 W.  
 BOOK PAGE 99 LINE 15