


STATE OF KANSAS
STATE CORPORATION COMMISSION

Form CP-4

Give All Information Completely
Make Required Affidavit
Mail or Deliver Report to:
Conservation Division
State Corporation Commission
212 No. Market
Wichita, Kansas

WELL PLUGGING RECORD

NORTH

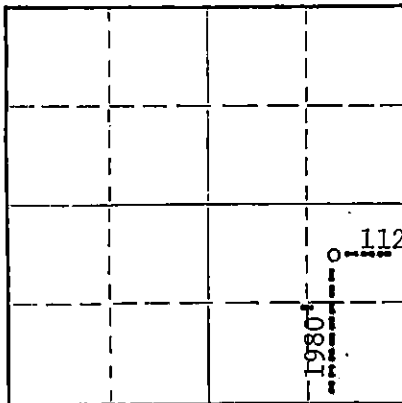

Locate well correctly on above
Section Plat

Meade County, Sec. 21, Twp. 33S, Rge. 28W (E) (W)
Location as "NE/CNW&SW" or footage from lines 1120' fr. E & 1980 fr. S
Lease Owner Horizon Oil & Gas Co.
Lease Name Nash Well No. 1-21
Office Address P.O. Box 7, Spearman, Texas 79081
Character of Well (completed as Oil, Gas or Dry Hole) Dry Hole
Date well completed April 2, 19 67
Application for plugging filed April 3, 19 67
Application for plugging approved April 3, 19 67
Plugging commenced April 3, 19 67
Plugging completed April 3, 19 67
Reason for abandonment of well or producing formation Dry Hole

If a producing well is abandoned, date of last production none, 19
Was permission obtained from the Conservation Division or its agents before plugging was commenced? Yes - (From Edgar J. Eves - by telephone)

Name of Conservation Agent who supervised plugging of this well Edgar J. Eves - Sublette, Kansas
Producing formation noen Depth to top - Bottom - Total Depth of Well 5960 Feet
Show depth and thickness of all water, oil and gas formations.

OIL, GAS OR WATER RECORDS

CASING RECORD

FORMATION	CONTENT	FROM	TO	SIZE	PUT IN	PULLED OUT
	water	4800	TD	8-5/8"	1450	NONE

Describe in detail the manner in which the well was plugged, indicating where the mud fluid was placed and the method or methods used in introducing it into the hole. If cement or other plugs were used, state the character of same and depth placed, from 744 feet to surface feet for each plug set.

Set 35 sx. cement plug @ 744' to 594', 15 sack cement plug 40' to surface.
Welded on cap. Well D & A.

RECEIVED
STATE CORPORATION COMMISSION

APR 7 1967

CONSERVATION DIVISION
WICHITA, KANSAS

(If additional description is necessary, use BACK of this sheet)

Name of Plugging Contractor Halliburton
Address Liberal, Kansas

STATE OF Texas, COUNTY OF Hansford, ss.
Everett R. Tracy (employee of owner) or (agent) of the above-described well, being first duly sworn on oath, says: That I have knowledge of the facts, statements, and matters herein contained and the log of the above-described well as filed and that the same are true and correct. So help me God.

(Signature) Everett R. Tracy Prod. Mgr.

P.O. Box 7, Spearman, Texas 79081
(Address)

SUBSCRIBED AND SWORN to before me this 5th day of April, 19 67

My commission expires June 1, 1967

Hansford County, Texas Notary Public.