

INITIAL COMPLETION REPORT ONLY

SIDE ONE

STATE CORPORATION COMMISSION OF KANSAS  
OIL & GAS CONSERVATION DIVISION  
WELL COMPLETION OR RECOMPLETION FORM  
ACO-1 WELL HISTORY  
DESCRIPTION OF WELL AND LEASE

Operator: License # 5447  
Name OXY USA Inc.  
Address 3545 N.W. 58th Street  
City/State/Zip Oklahoma City, OK 73112

Purchaser Unknown at this time

Operator Contact Person Raymond Hui  
Phone (405) 949-4400

Contractor: License # 5421  
Name Sage Drilling Company

Wellsite Geologist Robert Vick  
Phone (405) 949-4400

Designate Type of Completion  
 New Well  Re-Entry  Workover

Oil  SWD  Temp Abd  
 Gas  Inj  Delayed Comp.  
 Dry  Other (Core, Water Supply etc.)

If OWNED: old well Info as follows:  
Operator  
Well Name  
Comp. Date  
Old Total Depth

WELL HISTORY

Drilling Method:  
 Mud Rotary  Air Rotary  Cable  
3-31-1988 4-13-1988 Pending  
Spud Date Date Reached TD Completion Date  
6450 3126'  
Total Depth PBTD

Amount of Surface Pipe Set and Cemented at 1667 feet  
Multiple Stage Cementing Collar Used? Yes  No  
If yes, show depth set feet  
If alternate 2 completion, cement circulated from feet depth to w/ SX cmt  
Cement Company Name  
Invoice # A-I

API NO. 15-175-21003-0000  
County Seward  
SE/4 SE/4 NE/4 26 32S 34 East  
Sec. Twp. Rge. X West

2970 Ft North from Southeast Corner of Section  
330 Ft West from Southeast Corner of Section  
(Note: Locate well in section plat below)  
(Formerly Hitch N #2)


Lease Name Boyer B Well #2

Field Name Kansas Hugoton Gas

Producing Formation Chase

Elevation: Ground 2889' KB 2900'

Section Plat

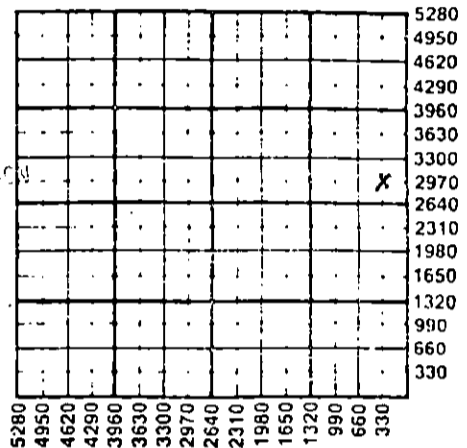

RECORDED  
STATE CORPORATION COMMISSION  
JUN 28 1988  
6-28-88  
OIL & GAS DIVISION  
WICHITA, KANSAS

WATER SUPPLY INFORMATION

Disposition of Produced Water: Disposal  
Docket # Repressuring

Questions on this portion of the ACO-1 call:

Water Resources Board (913) 296-3717

Source of Water:  
Division of Water Resources Permit # T88-115

Groundwater 3070 Ft North from Southeast Corner  
(Well) 230 Ft West from Southeast Corner of  
Sec 26 Twp 32S Rge 34 East  West

Surface Water Ft North from Southeast Corner  
(Stream, pond etc) Ft West from Southeast Corner  
Sec Twp Rge East West

Other (explain) (purchased from city, R.W.D. #)

INSTRUCTIONS: This form shall be completed in triplicate and filed with the Kansas Corporation Commission, 200 Colorado Derby Building, Wichita, Kansas 67202, within 120 days of the spud date of any well. Rule 82-3-130, 82-3-107 and 82-3-106 apply. Information on side two of this form will be held confidential for a period of 12 months if requested in writing and submitted with the form. See rule 82-3-107 for confidentiality in excess of 12 months. One copy of all wireline logs and drillers time log shall be attached with this form. Submit CP-4 form with all plugged wells. Submit CP-111 form with all temporarily abandoned wells.

All requirements of the statutes, rules and regulations promulgated to regulate the oil and gas industry have been fully complied with and the statements herein are complete and correct to the best of my knowledge.

Signature Bryan Humphries  
Title Engineering Manager Date 6-21-88

Subscribed and sworn to before me this 21st day of June 1988  
Notary Public Marsha G. Wilson

Date Commission Expires 4-1-92

K.C.C. OFFICE USE ONLY  
 Letter of Confidentiality Attached  
 Wireline Log Received  
 Drillers Time Log Received  
Distribution  
 KCC  SWD/Rep  NGPA  
 KGS  Plug  Other (Specify)  
6-28-88

Sec 26 Twp 32 Rge 34