ORIGINAL

CONFIDENTIAL

SIDE ONE

STATE CORPORATION COMMISSION OF KANSAS
OIL & GAS CONSERVATION DIVISION
WELL COMPLETION FORM
ACO-1 WELL HISTORY
DESCRIPTION OF WELL AND LEASE

API NO. 15- 129-21,044-00-00

County Morton

App C E/2 NE NE Sec. 25 Twp. 33S Rge. 40 ___ East X West

4620 Ft. North from Southeast Corner of Section

1250 Ft. West from Southeast Corner of Section
(NOTE: Locate well in section plat below.)

Lease Name Stout "B" Well # 3

Field Name Wildcat

Producing Formation None

Elevation: Ground 3277.6 KB NA

Total Depth 6450 PBTD 0

Operator: License # 4549

Name: Anadarko Petroleum Corporation

Address P. O. Box 351

City/State/Zip Liberal, KS 67905-0351

Purchaser: None

Operator Contact Person: J. L. Ashton


Phone (316) 624-6253

Contractor: Name: Gabbert - Jones, Inc.

License: 5842

Wellsite Geologist: NA

RECEIVED
STATE CORPORATION COMMISSION
JUL 27 1990
7-27-90
CONSERVATION DIVISION

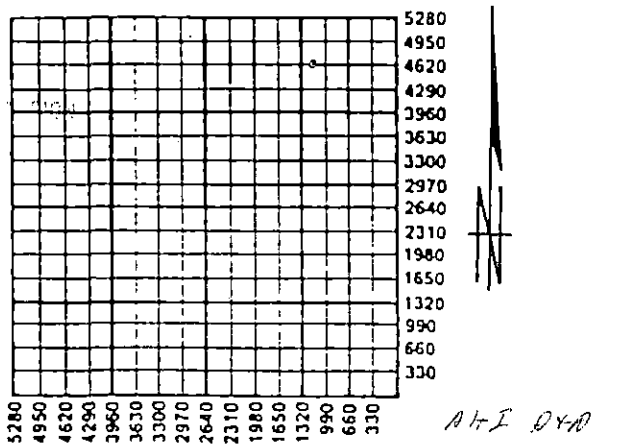

Designate Type of Completion
X New Well ___ Re-Entry ___ Workover

___ Oil ___ SWD ___ Temp. Abd.
___ Gas ___ Inj ___ Delayed Comp.
X Dry ___ Other (Core, Water Supply, etc.)

If OWWO: old well info as follows:
Operator:

Well Name:

Comp. Date ___ Old Total Depth ___

Drilling Method:
X Mud Rotary ___ Air Rotary ___ Cable

5-16-90 Spud Date
5-28-90 Date Reached TD
5-29-90 Completion Date

Amount of Surface Pipe Set and Cemented at 1654 Feet

Multiple Stage Cementing Collar Used? ___ Yes X No

If yes, show depth set ___ Feet

If Alternate II completion, cement circulated from ___

feet depth to ___ w/ ___ sx cmt.

INSTRUCTIONS: This form shall be completed in triplicate and filed with the Kansas Corporation Commission, 200 Colorado Derby Building, Wichita, Kansas 67202, within 120 days of the spud date of any well. Rule 82-3-130, 82-3-107 and 82-3-106 apply. Information on side two of this form will be held confidential for a period of 12 months if requested in writing and submitted with the form. See rule 82-3-107 for confidentiality in excess of 12 months. One copy of all wireline logs and drillers time log shall be attached with this form. ALL CEMENTING TICKETS MUST BE ATTACHED. Submit CP-4 form with all plugged wells. Submit CP-111 form with all temporarily abandoned wells. Any recompletion, workover or conversion of a well requires filing of ACO-2 within 120 days from commencement date of such work.

All requirements of the statutes, rules and regulations promulgated to regulate the oil and gas industry have been fully complied with and the statements herein are complete and correct to the best of my knowledge.

Signature Beverly J. Williams
Beverly J. Williams
Title Engineering Technician Date 7-24-90

Subscribed and sworn to before me this 24th day of July, 19 90.

Notary Public Cheryl Steers

Date Commission Expires

CHERYL STEERS
Notary Public - State of Kansas
My Appt. Expires 6-1-93

K.C.C. OFFICE USE ONLY
F ✓ Letter of Confidentiality Attached
C ___ Wireline Log Received
C ___ Drillers Timelog Received

Distribution
✓ KCC ___ SWD/Rep ___ NGPA
___ KGS ___ Plug ___ Other (Specify)

Form ACO-1 (7-89)