

STATE CORPORATION COMMISSION OF KANSAS
OIL & GAS CONSERVATION DIVISION
WELL COMPLETION OR RECOMPLETION FORM
ACO-1 WELL HISTORY
DESCRIPTION OF WELL AND LEASE

Operator: License # 4549
Name Anadarko Petroleum Corporation
Address P. O. Box 351
City/State/Zip Liberal, Kansas 67905-0351

Purchaser NA

Operator Contact Person M. L Pease
Phone (316) 624-6253

Contractor: License # 5842
Name Gabbert-Jones, Inc.

Wellsite Geologist Mike Dodge
Phone (303) 595-3326

Designate Type of Completion
 New Well Re-Entry Workover
 Oil SWD Temp Abd
 Gas Inj Delayed Comp.
 Dry Other (Core, Water Supply etc.)

If OWWO: old well info as follows:
Operator
Well Name
Comp. Date Old Total Depth

WELL HISTORY

Drilling Method:
 Mud Rotary Air Rotary Cable
4/29/89 5/13/89 NA
Spud Date Date Reached TD Completion Date
6150 2774
Total Depth PBT
Amount of Surface Pipe Set and Cemented at 1637 feet
Multiple Stage Cementing Collar Used? Yes No
If yes, show depth set feet
If alternate 2 completion, cement circulated from feet depth to w/ SX cmt
Cement Company Name BJ Titan Services
Invoice # SLO26-512505
A/I

API NO. 15-129-20,983-0000
County Morton
NW SE SE Sec. 28 Twp. 33S Rge. 40 East West

1050 Ft North from Southeast Corner of Section
1100 Ft West from Southeast Corner of Section
(Note: Locate well in section plat below)


Lease Name Mingenback "C" Well # 1-A

Field Name Grasshopper Prospect ~~NA~~ Aug.

Producing Formation

Elevation: Ground 3314 KB 3328

Section Plat

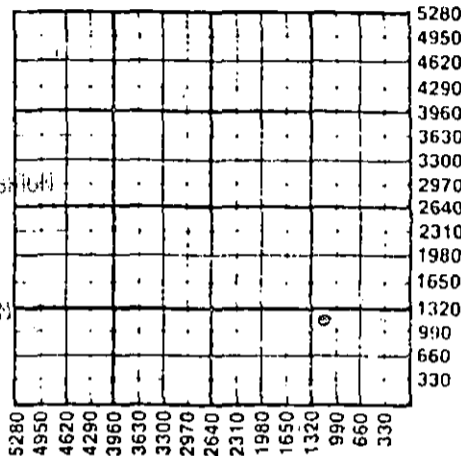

RECEIVED
STATE CORPORATION COMMISSION
AUG 23 1989
8-23-89
CONSERVATION DIVISION
WICHITA, KANSAS

WATER SUPPLY INFORMATION

Disposition of Produced Water: Disposal
Docket # Repressuring

Questions on this portion of the ACO-1 call:

Water Resources Board (913) 296-3717
Source of Water:
Division of Water Resources Permit #
Groundwater Ft North from Southeast Corner (Well) Ft West from Southeast Corner of Sec Twp Rge East West
Surface Water Ft North from Southeast Corner (Stream, pond etc) Ft West from Southeast Corner Sec Twp Rge East West
 Other (explain) Provided by Contractor (purchased from city, R.W.D. #)

INSTRUCTIONS: This form shall be completed in triplicate and filed with the Kansas Corporation Commission, 200 Colorado Derby Building, Wichita, Kansas 67202, within 120 days of the spud date of any well. Rule 82-3-130, 82-3-107 and 82-3-106 apply. Information on side two of this form will be held confidential for a period of 12 months if requested in writing and submitted with the form. See rule 82-3-107 for confidentiality in excess of 12 months. One copy of all wireline logs and drillers time log shall be attached with this form. Submit CP-4 form with all plugged wells. Submit CP-111 form with all temporarily abandoned wells.

All requirements of the statutes, rules and regulations promulgated to regulate the oil and gas industry have been fully complied with and the statements herein are complete and correct to the best of my knowledge.


Signature M. L Pease

Title Division Production Manager Date 8/21/89

Subscribed and sworn to before me this 21st day of August 1989

Notary Public Cheryl Steers

Date Commission Expires

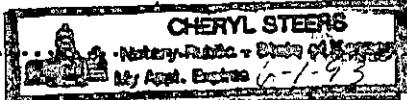

K.C.C. OFFICE USE ONLY
 Letter of Confidentiality Attached
 Wireline Log Received
 Drillers Timelog Received
Distribution
 KCC SWD/Rep NGPA
 KGS Plug Other (Specify)

Sec 28 Twp 33 Rge 40