

STATE CORPORATION COMMISSION OF KANSAS  
OIL & GAS CONSERVATION DIVISION  
WELL COMPLETION OR RECOMPLETION FORM  
ACO-1 WELL HISTORY  
DESCRIPTION OF WELL AND LEASE

Operator: License # 6378  
Name Hawkins Oil & Gas, Inc.  
Address P.O. Box 1282  
City/State/Zip Liberal, KS 67905-1282

Purchaser n/a

Operator Contact Person Frank Gagliardi  
Phone (918) 585-3121

Contractor: License # 6033  
Name Murfin Drilling Company

Wellsite Geologist Roger Bare  
Phone (405) 453-7944

Designate Type of Completion  
 New Well  Re-Entry  Workover

Oil  SWD  Temp Abd  
 Gas  Inj  Delayed Comp  
 Dry  Other (Core, Water Supply etc.)

If OWO: old well info as follows:  
Operator  
Well Name  
Comp. Date Old Total Depth

WELL HISTORY

Drilling Method:  
 Mud Rotary  Air Rotary  Cable

4-24-89 5-4-89 5-5-89  
Spud Date Date Reached TD Completion Date

5200' n/a  
Total Depth PBDT

Amount of Surface Pipe Set and Cemented at 1622 feet  
Multiple Stage Cementing Collar Used?  Yes  No  
If yes, show depth set feet  
If alternate 2 completion, cement circulated from feet depth to w/ SX cmt  
Cement Company Name  
Invoice #

*NTI DPA*

API NO. 15-129-20,978 - 00-00  
County Morton  
C. SE NW SW Sec. 16 Twp. 32S Rge. 43W West  
1650 Ft North from Southeast Corner of Section  
4290 Ft West from Southeast Corner of Section  
(Note: Locate well in section plat below)


Lease Name DRYER "A" Well # 1-16

Field Name n/a

Producing Formation n/a

Elevation: Ground 3636' KB 3646'

Section Plat

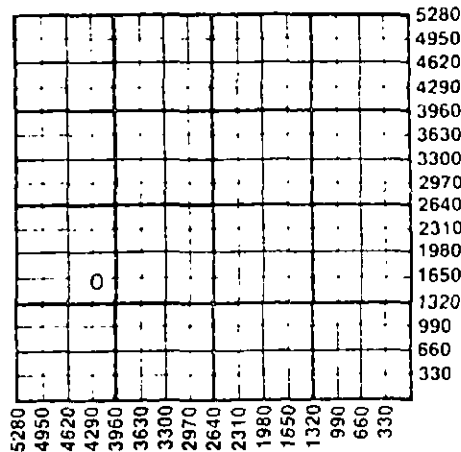

WATER SUPPLY INFORMATION

Disposition of Produced Water: Disposal  
Docket # Repressuring

Questions on this portion of the ACO-1 call:

Water Resources Board (913) 296-3717

Source of Water: pumped  
Division of Water Resources Permit #

Groundwater 1650 Ft North from Southeast Corner (Well) 4290 Ft West from Southeast Corner of Sec 16 Twp 32S Rge 43W East West

Surface Water Ft North from Southeast Corner (Stream, pond etc) Ft West from Southeast Corner Sec Twp Rge East West

Other (explain) (purchased from city, R.W.D. #)

INSTRUCTIONS: This form shall be completed in triplicate and filed with the Kansas Corporation Commission, 200 Colorado Derby Building, Wichita, Kansas 67202, within 120 days of the spud date of any well. Rule 82-3-130, 82-3-107 and 82-3-106 apply.

Information on side two of this form will be held confidential for a period of 12 months if requested in writing and submitted with the form. See rule 82-3-107 for confidentiality in excess of 12 months. One copy of all wireline logs and drillers time log shall be attached with this form. Submit CP-4 form with all plugged wells. Submit CP-111 form with all temporarily abandoned wells.

All requirements of the statutes, rules and regulations promulgated to regulate the oil and gas industry have been fully complied with and the statements herein are complete and correct to the best of my knowledge.

Signature T. J. Diseker

Title Operations Superintendent Date 6-2-89

Subscribed and sworn to before me this 2nd day of June 1989

Notary Public Jimmy Lee Barlow

Date Commission Expires 4-13-90

NOTARY PUBLIC - State of Kansas  
JIMMY LEE BARLOW  
My Appt. Exp. 4-13-90

K.C.C. OFFICE USE ONLY  
 Letter of Confidentiality Attached  
 Wireline Log Received  
 Drillers Timelog Received  
Distribution  
 KCC  SWD/Rep  NGPA  
 KGS  Plug  Other (Specify)  
6-5-89