

CONFIDENTIAL
SIDE ONE

STATE CORPORATION COMMISSION OF KANSAS
OIL & GAS CONSERVATION DIVISION
WELL COMPLETION FORM
ACO-1 WELL HISTORY
DESCRIPTION OF WELL AND LEASE

Operator: License # 5447

Name: OXY USA Inc.

Address P. O. Box 26100

Oklahoma City, OK 73126-0100

City/State/Zip _____

Purchaser: PEPL

Operator Contact Person: Raymond Hui

Phone (405) 749-2471

Contractor: Name: Zenith Drilling Company

License: _____

Wellsite Geologist: Andrew Howell

Designate Type of Completion

New Well Re-Entry Workover

Oil SWD Temp. Abd.

Gas Inj Delayed Comp.

Dry Other (Core, Water Supply, etc.)

If OWMO: old well info as follows:

Operator: _____

Well Name: _____

Comp. Date _____ Old Total Depth _____

Drilling Method:

Mud Rotary Air Rotary Cable

12-4-1989 12-21-1989 2-11-1990

Spud Date Date Reached TD Completion Date

API NO. 15- 189-21395-0000

County Stevens

CSW NE/4 Sec. 3 Twp. 32S Rge. 39 East West

3300 Ft. North from Southeast Corner of Section

1980 Ft. West from Southeast Corner of Section
(NOTE: Locate well in section plat below.)


Lease Name Younggren A Well # 1

Field Name East Kinsler

Producing Formation Morrow S-4

Elevation: Ground 3220' KB 3231'

Total Depth 6250' PBD 6055'

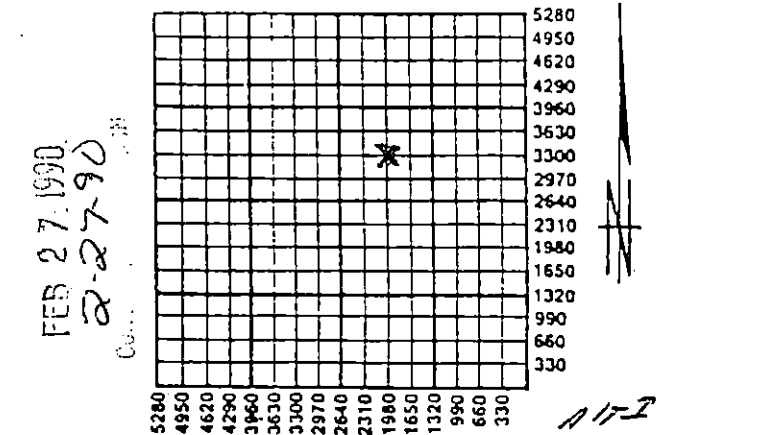

Amount of Surface Pipe Set and Cemented at 1706' Feet

Multiple Stage Cementing Collar Used? Yes No

If yes, show depth set DV Tool at 3099' Feet

If Alternate II completion, cement circulated from _____

feet depth to _____ w/ _____ sx cmt.

INSTRUCTIONS: This form shall be completed in triplicate and filed with the Kansas Corporation Commission, 200 Colorado Derby Building, Wichita, Kansas 67202, within 120 days of the spud date of any well. Rule 82-3-130, 82-3-107 and 82-3-106 apply. Information on side two of this form will be held confidential for a period of 12 months if requested in writing and submitted with the form. See rule 82-3-107 for confidentiality in excess of 12 months. One copy of all wireline logs and drillers time log shall be attached with this form. ALL CEMENTING TICKETS MUST BE ATTACHED. Submit CP-4 form with all plugged wells. Submit CP-111 form with all temporarily abandoned wells. Any recompletion, workover or conversion of a well requires filing of ACO-2 within 120 days from commencement date of such work.

All requirements of the statutes, rules and regulations promulgated to regulate the oil and gas industry have been fully complied with and the statements herein are complete and correct to the best of my knowledge.

Signature Bryan Humphries

Title Manager Engineering Date 2-26-1990

Subscribed and sworn to before me this 26th day of February, 19 90.

Notary Public Deborah Kay Mathes

Date Commission Expires 3/24/90

K.C.C. OFFICE USE ONLY

Letter of Confidentiality Attached

Wireline Log Received

Drillers Timelog Received

Distribution

KCC SWD/Rep NGPA

KGS Plug Other (Specify)