

STATE CORPORATION COMMISSION OF KANSAS
OIL & GAS CONSERVATION DIVISION
WELL COMPLETION FORM
ACO-1 WELL HISTORY
DESCRIPTION OF WELL AND LEASE

API NO. 15- 189-21712-~~00~~-~~00~~ **ORIGINAL**

County Stevens

 - - C - SE4 Sec. 19 Twp. 33 S Rge. 36 X W

1320 Feet from S/N (circle one) Line of Section

1420 Feet from E/W (circle one) Line of Section

Footages Calculated from Nearest Outside Section Corner:
NE, SE, NW or SW (circle one)

Lease Name CP-Paden, R.A. Well # 1

Field Name Hugoton

Producing Formation NA

Elevation: Ground 3065 KB NA

Total Depth 95 PBDT NA

Amount of Surface Pipe Set and Cemented at None Feet

Multiple Stage Cementing Collar Used? NA Yes NA No

If yes, show depth set NA Feet

If Alternate II completion, cement circulated from NA feet depth to NA w/ NA sx cmt.

Drilling Fluid Management Plan alt III CB
(Data must be collected from the Reserve Pit) 12-16-94

Chloride content NA ppm Fluid volume NA bbls

Dewatering method used NA

Location of fluid disposal if hauled offsite:

Operator Name NA

Lease Name NA License No.

NA Quarter Sec. NA Twp. NA S Rng. NA E/W

County NA Docket No. NA

Operator: License # 5208

Name: Mobil Oil Corporation

Address P.O. Box 2173
2319 North Kansas Avenue

City/State/Zip Liberal, KS 67905-2173

Purchaser:

Operator Contact Person: Sharon Cook

Phone (316) 626-1142

Contractor: Name: CP

License: 31474

Wellsite Geologist:

Designate Type of Completion
 New Well Re-Entry Workover

 Oil SWD SIGW Temp. Abd.
 Gas ENHR SIGW
 Dry X Other (Core, WSW, Expl., Cathodic, etc)

If Workover:

Operator:

Well Name:

Comp. Date Old Total Depth

 Deepening Re-perf. Conv. to Inj/SWD
 Plug Back PBDT

 Commingled Docket No.
 Dual Completion Docket No.
 Other (SWD or Inj?) Docket No.

7-20-94 7-20-94
Spud Date Date Reached TD Completion Date

INSTRUCTIONS: An original and two copies of this form shall be filed with the Kansas Corporation Commission, 200 Colorado Derby Building, Wichita, Kansas 67202, within 120 days of the spud date, recompletion, workover or conversion of a well. Rule 82-3-130, 82-3-106 and 82-3-107 apply. Information on side two of this form will be held confidential for a period of 12 months if requested in writing and submitted with the form (see rule 82-3-107 for confidentiality in excess of 12 months). One copy of all wireline logs and geologist well report shall be attached with this form. ALL CEMENTING TICKETS MUST BE ATTACHED. Submit CP-4 form with all plugged wells. Submit CP-111 form with all temporarily abandoned wells.

All requirements of the statutes, rules and regulations promulgated to regulate the oil and gas industry have been fully complied with and the statements herein are complete and correct to the best of my knowledge.

Signature Sharon A. Cook Sharon A. Cook

Title Regulatory Assistant Date 8-19-94

Subscribed and sworn to before me this 23 day of August, 19 94.

Notary Public Edith L. Cunningham

Date Commission Expires November 8, 1995

K.C.C. OFFICE USE ONLY

F Letter of Confidentiality Attached
C Wireline Log Received
C Geologist Report Received

Distribution
 KCC SWD/Rep NGPA
 KGS Plug Other (Specify)



RECEIVED
STATE CORPORATION COMMISSION
AUG 24 1994
CONSERVATION DIVISION
WICHITA, KANSAS

91

Operator Name Mobil Oil Corporation Lease Name CP-Paden R.A. Well # 1

Sec. 19 Twp. 33 S Rge. 36 East West County Stevens

INSTRUCTIONS: Show important tops and base of formations penetrated. Detail all cores. Report all drill stem tests giving interval tested, time tool open and closed, flowing and shut-in pressures, whether shut-in pressure reached static level, hydrostatic pressures, bottom hole temperature, fluid recovery, and flow rates if gas to surface during test. Attach extra sheet if more space is needed. Attach copy of log.

Drill Stem Tests Taken (Attach Additional Sheets.)	<input type="checkbox"/> Yes <input checked="" type="checkbox"/> No	<input checked="" type="checkbox"/> Log	Formation (Top), Depth and Datums	<input type="checkbox"/> Sample
Samples Sent to Geological Survey	<input type="checkbox"/> Yes <input checked="" type="checkbox"/> No	Name	Top	Datum
Cores Taken	<input type="checkbox"/> Yes <input checked="" type="checkbox"/> No	SEE ATTACHED DRILLER'S LOG		
Electric Log Run (Submit Copy.)	<input type="checkbox"/> Yes <input checked="" type="checkbox"/> No			
List All E.Logs Run:				
Electric Resistance Log - Attached				

CASING RECORD <input type="checkbox"/> New <input type="checkbox"/> Used							
Report all strings set-conductor, surface, intermediate, production, etc.							
Purpose of String	Size Hole Drilled	Size Casing Set (In O.D.)	Weight Lbs./Ft.	Setting Depth	Type of Cement	# Sacks Used	Type and Percent Additives

ADDITIONAL CEMENTING/SQUEEZE RECORD				
Purpose:	Depth Top Bottom	Type of Cement	#Sacks Used	Type and Percent Additives
<input type="checkbox"/> Perforate				
<input type="checkbox"/> Protect Casing				
<input type="checkbox"/> Plug Back TD				
<input checked="" type="checkbox"/> Plug Off Zone				
	(1) First plug - Bentonite set at 25' - 2' plug.			
	(2) Second plug - Bentonite set at 15' - 12' plug.(See attached Cathodic Protection Borehole sketch).			

Shots Per Foot	PERFORATION RECORD - Bridge Plugs Set/Type Specify Footage of Each Interval Perforated	Acid, Fracture, Shot, Cement Squeeze Record (Amount and Kind of Material Used)	Depth
	First anode set at 65', second anode at 55', third anode at 35'.		

TUBING RECORD		Size	Set At	Packer At	Liner Run	<input type="checkbox"/> Yes <input type="checkbox"/> No	
1" PVC vent from TD to 3' above surface.					NA		
Date of First, Resumed Production, SWD or Inj. Installed 7-20-94				Producing Method	<input type="checkbox"/> Flowing <input type="checkbox"/> Pumping <input type="checkbox"/> Gas Lift <input type="checkbox"/> Other (Explain)		
Estimated Production Per 24 Hours	Oil	Bbls.	Gas	Mcf	Water	Bbls.	Gas-Oil Ratio
		NA		NA			
							Gravity

Disposition of Gas: **METHOD OF COMPLETION** Production Interval


Vented Sold Used on Lease Open Hole Perf. Dually Comp. Commingled

(If vented, submit ACO-18.) Other (Specify) _____

Cathodic Protection Borehole

CP-Paden, R.A. #1
Sec. 19-33S-36W
Stevens County, Kansas.

ORIGINAL

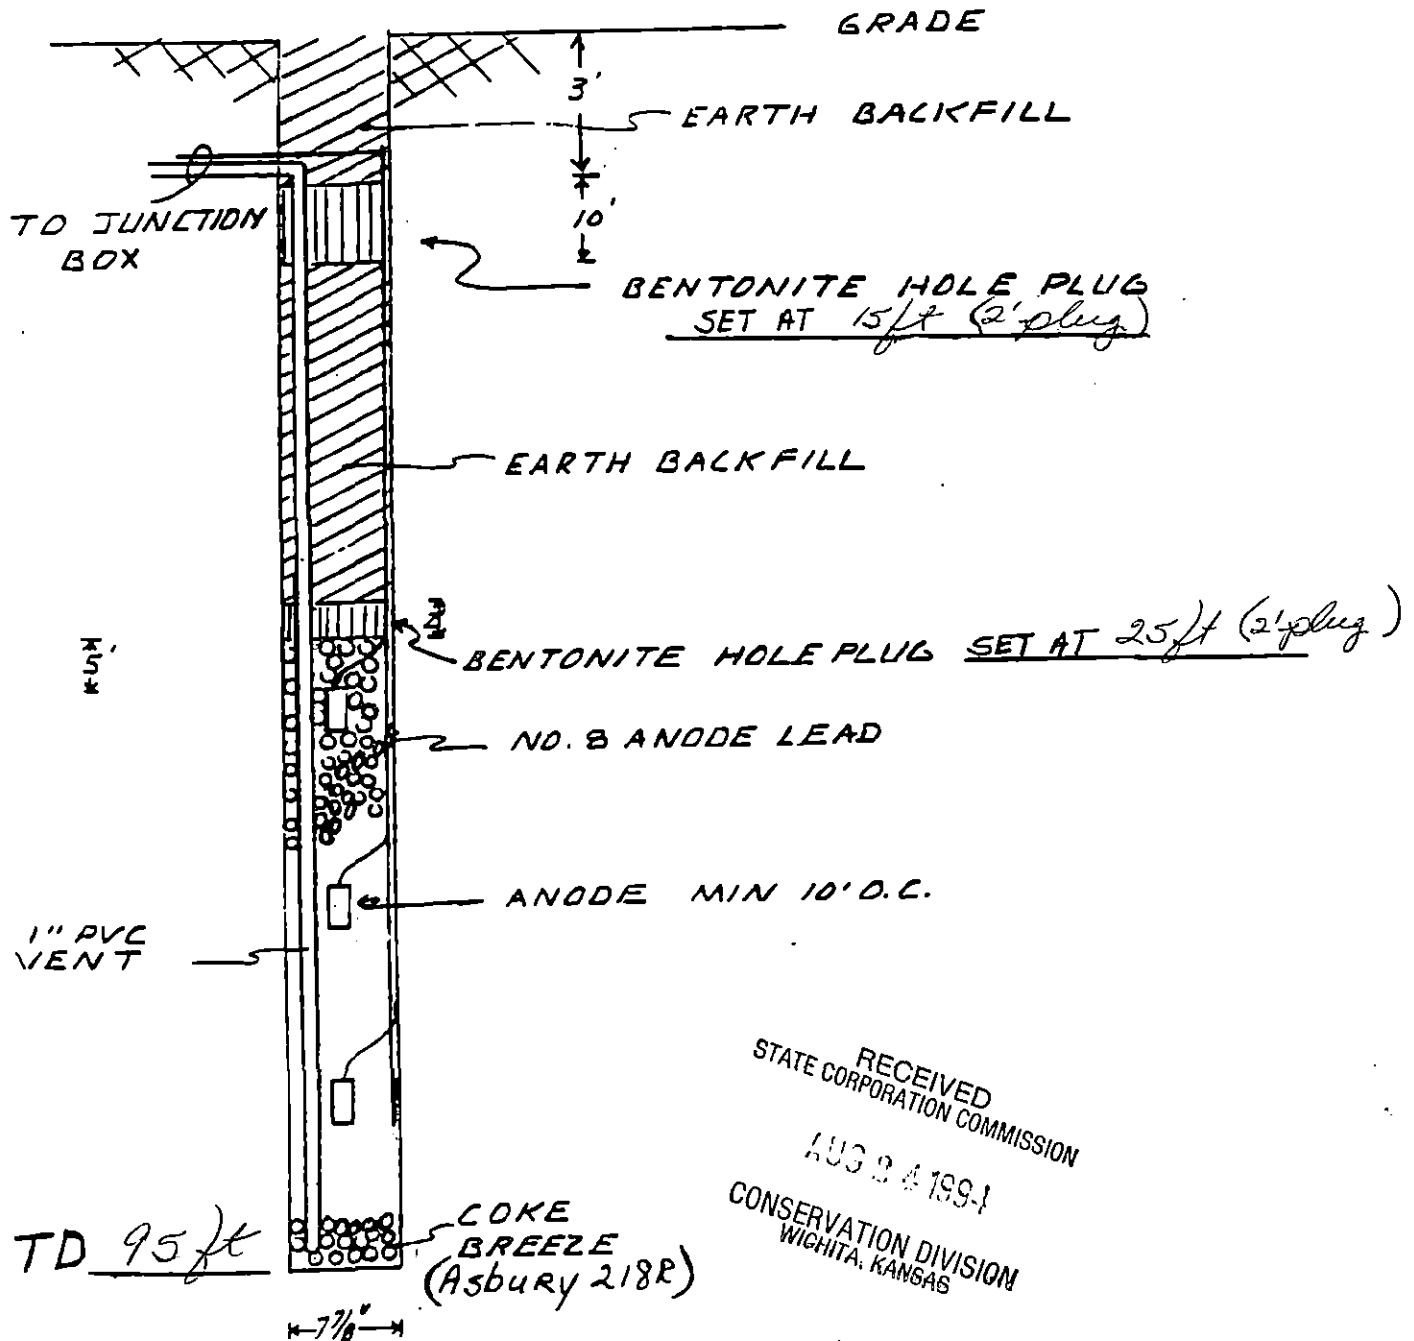

CATHODIC PROTECTION SERVICES COMPANY

LIBERAL, KANSAS

DATA SHEET NO. _____

COMPANY Mobil E&P JOB NO. 801-00370 DATE: 7/20/94
 WELL: R.A. Paden #1 PIPELINE: _____
 LOCATION: Sec. 19 Twp. 33 Rge. 36 Co. Steven State Kansas
 ROTARY 95 FT: _____ CASING _____ FT.

ORIGINAL

DEEP GROUND BED LOGGING DATA

DRILL LOG	DEPTH (FT)	ANODE TO STRUCTURE		ANODES		ANODE TO CABLE	DRILL LOG	DEPTH (FT)	ANODE TO STRUCTURE		ANODES		ANODE TO CABLE
		EXPLOR ohm	FINAL ohm	NO.	TOP DEPTH				EXPLOR ohm	FINAL ohm	NO.	TOP DEPTH	
Plug	5					15'-3'		205					
	10							210					
Earthfill	15					23'-15'		215					
	20							220					
Plug	25	.650				25'-23'		225					
	30	.550						230					
	35	1.11		3				235					
	40	.830				COKE		240					
	45	.410						245					
	50	.510				COLUMN		250					
	55	.670		2				255					
	60	.510						260					
	65	.680		1				265					
	70	.380						270					
	75	.340						275					
	80	.240						280					
	85	.270						285					
	90	.200						290					
	95	.250						295					
	100							300					
	105							305					
	110							310					
	115							315					
	120							320					
	125							325					
	130							330					
	135							335					
	140							340					
	145							345					
	150							350					
	155							355					
	160							360					
	165							365					
	170							370					
	175							375					
	180							380					
	185							385					
	190							390					
	195							395					
	200							400					

RECEIVED
 STATE CORPORATION COMMISSION
 AUG 22 1994
 CONSERVATION DIVISION
 WICHITA, KANSAS

GROUND BED RESISTANCE: (1) VOLTS _____ + AMPS = OHMS

Pit Backfilled
 7/20/94

(2) VIBROGROUND _____ OHMS

R.A. PADEN #1

CATHODIC PROTECTION SERVICES CO.
WELL TYPE GROUND BED DATA

CUSTOMER: MOBIL
LOCATION: 19-32-36

DRILLING COMPANY: RAY'S DRILLING
DRILLER: RAY

HOLE DEPTH: 95'
DIAMETER: 6"

CASING TYPE: STEEL PCV
SEAL TYPE: CEMENT BENTONITE

DATE: 7-20-94

DEPTH	CASING	SEAL	FORMATION LOG	H2O	SEAL	DEPTH	CASING	SEAL	FORMATION LOG	H2O	SEAL
5			BROWN CLAY			305					
10						310					
15						315					
20			BROWN SAND			320					
25						325					
30						330					
35						335					
40						340					
45						345					
50						350			ORIGINAL		
55						355					
60						360					
65						365					
70						370					
75						375					
80						380					
85						385					
90						390					
95						395					
100						400					
105						405					
110						410					
115						415					
120						420					
125						425					
130						430					
135						435					
140						440					
145						445					
150						450					
155						455					
160						460					
165						465					
170						470					
175						475					
180						480					
185						485					
190						490					
195						495					
200						500					
205						505					
210						510					
215						515					
220						520					
225						525					
230						530					
235						535					
240						540					
245						545					
250						550					
255						555					
260						560					
265						565					
270						570					
275						575					
280						580					
285						585					
290						590					
295						595					
300						600					

RECEIVED
STATE CORPORATION COMMISSION

AUG 2 1994

CONSERVATION DIVISION
WICHITA, KANSAS

BC-DL941

17