

This form shall be filed in duplicate with the Kansas Corporation Commission, 200 Colorado Derby Building, Wichita, Kansas 67202, within ten days after the completion of the well, regardless of how the well was completed.

Attach separate letter of request if the information is to be held confidential. If confidential, only file one copy. Information on side one will be of public record and side two will then be held confidential.

Circle one: Oil, Gas, Dry, SWD, OWWO, Injection. Type and complete ALL sections. Applications must be filed for dual completion, commingling, SWD and injection.

Attach wireline logs (i.e. electrical log, sonic log, gamma ray neutron log, etc.). KCC # (316) 263-3238. (Rules 82-2-105 & 82-2-125)

OPERATOR SOUTHWEST GAS STORAGE COMPANY

API NO. 15-119-10092-00-01

ADDRESS P.O. Box 1348

COUNTY Meade

Kansas City, Missouri 64141

FIELD Borchers North

**CONTACT PERSON Mr. D. R. Carlile

PROD. FORMATION Observation

PHONE (316) 873-5469

LEASE Harris

PURCHASER Panhandle Eastern Pipe Line Company

WELL NO. 1-5

ADDRESS P.O. Box 1348

WELL LOCATION 1980' N & 661.7' E
From

Kansas City, Missouri 64141

_____ Ft. from _____ Line and

DRILLING Patrick Well Service

_____ Ft. from _____ Line of

CONTRACTOR

ADDRESS P.O. Box 1273

the SW/c SEC. 5 TWP. 33S RGE. 28W


Liberal, Kansas 67901

WELL PLAT

PLUGGING

CONTRACTOR

ADDRESS

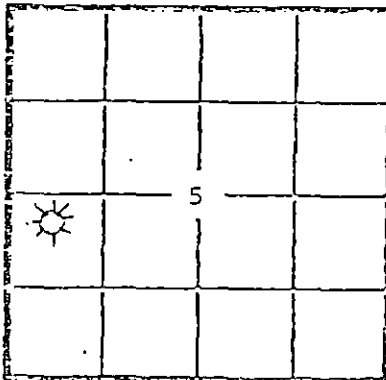

KCC
KGS
(Office Use)

TOTAL DEPTH 5781 PBDT 5727

Re-Entry 9-6-80

SPUD DATE 1959 DATE COMPLETED 9-28-81

ELEV: GR 2487 DF _____ KB _____

DRILLED WITH (CABLE) (ROTARY) (AIR) TOOLS

Amount of surface pipe set and cemented 1532 DV Tool Used? No

A F F I D A V I T

RECEIVED
STATE CORPORATION COMMISSION

STATE OF KANSAS, COUNTY OF MEADE SS, I, JUN 9 1982

D. R. CARLILE OF LAWFUL AGE, BEING FIRST DULY SWORN UPON HIS OATH,

CONSERVATION DIVISION
Wichita, Kansas

DEPOSES THAT HE IS FIELD SUPERINTENDENT (FOR)(OF) SOUTHWEST GAS STORAGE COMPANY

OPERATOR OF THE BORCHERS NORTH GAS STORAGE FIELD LEASE, AND IS DULY AUTHORIZED TO MAKE

THIS AFFIDAVIT FOR AND ON THE BEHALF OF SAID OPERATOR, THAT WELL NO. 1-5 ON

SAID LEASE HAS BEEN COMPLETED AS OF THE 28 DAY OF SEPTEMBER, 19 81, AND THAT

ALL INFORMATION ENTERED HEREIN WITH RESPECT TO SAID WELL IS TRUE AND CORRECT.

FURTHER AFFIANT SAITH NOT.

(S) [Signature]

SUBSCRIBED AND SWORN BEFORE ME THIS 9th DAY OF June, 19 82

[Signature]
NOTARY PUBLIC

MY COMMISSION EXPIRES: 2/27/84

**The person who can be reached by phone regarding any questions concerning this information. Within 45 days of completion, a witnessed initial test by the Commission is required if the well produces more than 25 FOPD or is located in a Basic Order Pool.