

This form shall be filed in duplicate with the Kansas Corporation Commission, 200 Colorado Derby Building, Wichita, Kansas 67202, within ten days after the completion of the well, regardless of how the well was completed.

Attach separate letter of request if the information is to be held confidential. If confidential, only file one copy. Information on side one will be of public record and side two will then be held confidential.

Circle one: Oil, Gas, Dry, SWD, OWO, Injection. Type and complete ALL sections. Applications must be filed for dual completion, commingling, SWD and injection. (GAS STORAGE)

Attach wireline logs (i.e. electrical log, sonic log, gamma ray neutron log, etc.). KCC # (316) 263-3238. (Rules 82-2-105 & 82-2-125)

OPERATOR Southwest Gas Storage Company

API NO. 15-119-20,418-00-00

ADDRESS Box 1348

COUNTY Meade

Kansas City, Missouri 64141

FIELD Borchers North

**CONTACT PERSON Mr. D. R. Carlile

PROD. FORMATION Morrow

PHONE (316) 873-5469

LEASE Harris

PURCHASER Panhandle Eastern Pipe Line Company

WELL NO. 2-5

ADDRESS P. O. Box 1348

WELL LOCATION 2397'N & 156'W from

Kansas City, Missouri 64141

Ft. from Line and

DRILLING Sage Drilling Company, Inc.

Ft. from Line of

CONTRACTOR

ADDRESS 222 Sutton Place

the SE/4 SEC. 5 TWP. 33S RGE. 28W


Wichita, Kansas 67202

WELL PLAT

PLUGGING

CONTRACTOR

ADDRESS

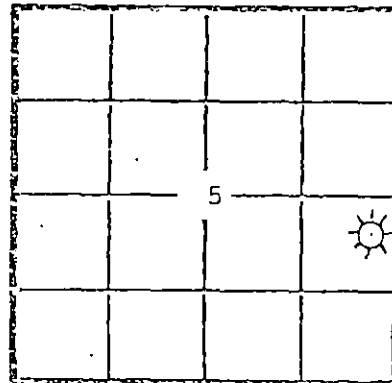

KCC
KGS
(Office Use)

TOTAL DEPTH 5660' PBTD 5600'

SPUD DATE 7-29-80 DATE COMPLETED 7-7-81

ELEV: GR 2446' DF KB 2457'

DRILLED WITH (CABLE) (ROTARY) (AIR) TOOLS

Amount of surface pipe set and cemented 2535' DV Tool Used? No. JUN - 9 1982

A F F I D A V I T

RECEIVED STATE CORPORATION COMMISSION CONSERVATION DIVISION Wichita, Kansas

STATE OF KANSAS, COUNTY OF MEADE SS, I, DENNIS

R. CARLILE OF LAWFUL AGE, BEING FIRST DULY SWORN UPON HIS OATH,

DEPOSES THAT HE IS FIELD SUPERINTENDENT (FOR)(OF) SOUTHWEST GAS STORAGE COMPANY

OPERATOR OF THE BORCHERS NORTH GAS STG. FIELD LEASE, AND IS DULY AUTHORIZED TO MAKE

THIS AFFIDAVIT FOR AND ON THE BEHALF OF SAID OPERATOR, THAT WELL NO. 2-5 ON

SAID LEASE HAS BEEN COMPLETED AS OF THE 7th DAY OF JULY, 19 81, AND THAT

ALL INFORMATION ENTERED HEREIN WITH RESPECT TO SAID WELL IS TRUE AND CORRECT.

FURTHER AFFIANT SAITH NOT.

(S) [Signature]

SUBSCRIBED AND SWORN BEFORE ME THIS 23rd DAY OF April, 19 82

[Signature] NOTARY PUBLIC Wilma Pennington

appt. MY COMMISSION EXPIRES: June 16, 1982

**The person who can be reached by phone regarding any questions concerning this information. Within 45 days of completion, a witnessed initial test by the Commission is required if the well produces more than 25 EOPD or is located in a Basic Order Pool.