TYPE _____ AFFIDAVIT OF COMPLETION FORM ACO-1 WELL HISTORY

SIDE ONE Compt.____

Two (2) copies of this form shall be filed with the Kansas Corporation Commission, 200 Colorado Derby Building, Wichita, Kansas 67202, within thirty (30) days after the completion of a well, regardless of how the well was completed.

(F) ✓ Attach separate letter of request if the information is to be held confidential. If confidential, only file one copy. Information on Side One will be of public record and Side Two will then be held confidential.

Applications must be made on dual completion, commingling, salt water disposal, injection and temporarily abandoned wells.

(C) ✓ Attach one copy only wireline logs (i.e. electrical log, sonic log, gamma ray neutron log, etc.). (Rules 82-2-105 & 82-2-125) KCC# (316) 263-3238.

LICENSE # 5181 EXPIRATION DATE 06/30/83

OPERATOR DONALD C. SLAWSON API NO. 15-119-20,615-00-00

ADDRESS 200 Douglas Building COUNTY Meade

Wichita, Kansas 67202 FIELD

** CONTACT PERSON Sherry Kendall PROD. FORMATION N/A

PHONE 316-263-3201

PURCHASER N/A LEASE BLEHM 'A'

ADDRESS WELL NO. 3

WELL LOCATION SW NW NW

DRILLING CONTRACTOR SLAWSON DRILLING CO., INC. 990 Ft. from North Line and

ADDRESS 200 Douglas Building 330 Ft. from West Line of

Wichita, Kansas 67202 the NW (Qtr.) SEC 32 TWP 33 RGE 28 (E) (W).

PLUGGING CONTRACTOR Halliburton Services

ADDRESS Box 579

Great Bend, Kansas 67530

WELL PLAT

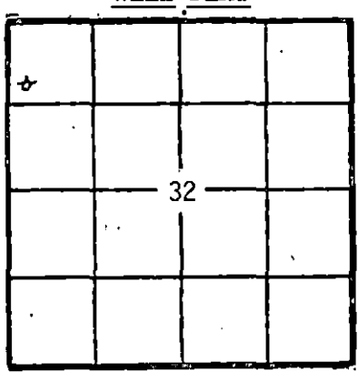

(Office Use Only)
KCC ✓
KGS ✓
SWD/REP__
PLG.____

TOTAL DEPTH 5715' PBTD N/A

SPUD DATE March 31, 1983 DATE COMPLETED April 14, 1983

ELEV: GR 2344 DF 2347 KB 2350

DRILLED WITH (~~CABLE~~) (ROTARY) (~~AIR~~) TOOLS.

DOCKET NO. OF DISPOSAL OR REPRESSURING WELL BEING USED TO DISPOSE OF WATER FROM THIS LEASE _____.

Amount of surface pipe set and cemented 1522.74' DV Tool Used? No.

THIS AFFIDAVIT APPLIES TO: (Circle ONE) - Oil, Gas, Shut-in Gas, Dry, Disposal, Injection, Temporarily Abandoned, OWWO. Other_____.

ALL REQUIREMENTS OF THE STATUTES, RULES AND REGULATIONS PROMULGATED TO REGULATE THE OIL AND GAS INDUSTRY HAVE BEEN FULLY COMPLIED WITH.

A F F I D A V I T

William R. Horigan, being of lawful age, hereby certifies that:

I am the Affiant, and I am familiar with the contents of the foregoing Affidavit. The statements and allegations contained therein are true and correct.

William R. Horigan
(Name)
William R. Horigan

SUBSCRIBED AND SWORN TO BEFORE ME this 20th day of June, 19 83.

SHERRY L. KENDALL
NOTARY PUBLIC
STATE OF KANSAS
My Appt. Exp. June 12, 1986

Sherry L. Kendall
(NOTARY PUBLIC)
Sherry L. Kendall

MY COMMISSION EXPIRES: 06/12/86

RECEIVED
STATE CORPORATION COMMISSION
JUL 07 1983
CONSERVATION DIVISION
Wichita, Kansas

** The person who can be reached by phone regarding any questions concerning this information.