


STATE OF KANSAS  
STATE CORPORATION COMMISSION  
Give All Information Completely  
Make Required Affidavit  
Mail or Deliver Report to:  
Conservation Division  
State Corporation Commission  
212 No. Market  
Wichita, Kansas

WELL PLUGGING RECORD

NORTH

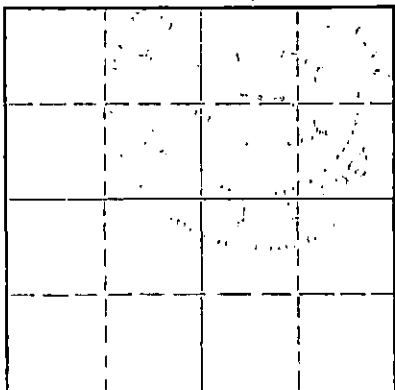

Locate well correctly on above Section Plat

Pratt County, Sec. 14 Twp. 28 Rge. 12 (EX) (W)  
Location as "NE/CNW/SW" or footage from lines C/2 SE SE  
Lease Owner Raymond Oil Co., Inc.  
Lease Name Chitwood O#12 Well No.  
Office Address Wichita, Kansas 67202  
Character of Well (completed as Oil, Gas or Dry Hole)  
Date well completed 19  
Application for plugging filed 19  
Application for plugging approved 19  
Plugging commenced 11/8/69 19  
Plugging completed 11/11/69 19  
Reason for abandonment of well or producing formation depleted.  
If a producing well is abandoned, date of last production 19  
Was permission obtained from the Conservation Division or its agents before plugging was commenced? yes

Name of Conservation Agent who supervised plugging of this well Warren  
Producing formation Depth to top Bottom Total Depth of Well 4397 Feet  
Show depth and thickness of all water, oil and gas formations.

OIL, GAS OR WATER RECORDS				CASING RECORD		
FORMATION	CONTENT	FROM	TO	SIZE	PUT IN	PULLED OUT
				10-3/4	331	none
				5 1/2	4377'	2808'

Describe in detail the manner in which the well was plugged, indicating where the mud fluid was placed and the method or methods used in introducing it into the hole. If cement or other plugs were used, state the character of same and depth placed, from feet to feet for each plug set.

Checked hole to 4397', ran sand to 4350' and ran 5 sacks of cement.  
Loaded hole with water, tried to pump plug out of pipe, couldn't.  
Shot pipe at 2791', got loose and pulled 90 joints. Bailed hole to 250', set 10' rock bridge and ran 35 sacks of cement. Mudded hole to 40', set 10' rock bridge and ran 15 sacks of cement.

PLUGGING COMPLETE.

RECEIVED  
STATE CORPORATION COMMISSION  
NOV 17 1969  
CONSERVATION DIVISION  
Wichita, Kansas

(If additional description is necessary, use BACK of this sheet)  
Name of Plugging Contractor KNIGHT CASING PULLING CO., INC.  
Address CHASE, KANSAS

STATE OF KANSAS COUNTY OF RICE, ss.  
NOEL J. KNIGHT (employee of owner) or (owner or operator) of the above-described well, being first duly sworn on oath, says: That I have knowledge of the facts, statements, and matters herein contained and the log of the above-described well as filed and that the same are true and correct. So help me God.

(Signature) Noel Knight CHASE, KANSAS (Address)  
Subscribed AND SWORN TO before me this 13th day of November 1969  
My commission expires 2/15/71  
Margaret Melcher Notary Public.

PAGE NO. 1

FORM NO. 176 - PAGE 1

Location 660' N & 990' W of SE Corner Sec 14 Field or Pool Chitwood

Remarks

RECEIVED  
STATE CORPORATION COMMISSION  
OCT 30 1969  
CONSERVATION DIVISION  
Wichita, Kansas  
145

MISSION			
		11	
SION			
			X

[illegible]