


WELL PLUGGING RECORD

Give All Information Completely
Make Required Affidavit
Mail or Deliver Report to:
Conservation Division
State Corporation Commission
800 Bitting Building
Wichita, Kansas

NORTH

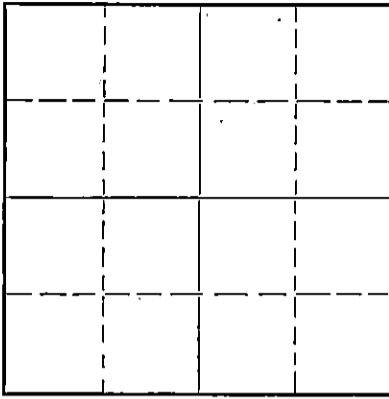

Locate well correctly on above
Section Plat

Pratt County. Sec. 14 Twp. 28 Rge. (E) 12 (W)
Location as "NE/CNW $\frac{1}{4}$ SW $\frac{1}{4}$ " or footage from lines Gen. E/2 SE SE
Lease Owner Cities Service Oil Company
Lease Name Rosenbaum Well No. 3
Office Address Bartlesville, Oklahoma
Character of Well (completed as Oil, Gas or Dry Hole) Dry Hole
Date well completed December 15, 19 50
Application for plugging filed December 15, 19 50
Application for plugging approved December 15, 19 50
Plugging commenced December 16, 19 50
Plugging completed December 16, 19 50
Reason for abandonment of well or producing formation Dry Hole

If a producing well is abandoned, date of last production ----- 19 -----
Was permission obtained from the Conservation Division or its agents before plugging was commenced? Yes

Name of Conservation Agent who supervised plugging of this well C. D. Stough
Producing formation Simpson Depth to top 4427 Bottom 4447 Total Depth of Well 4447 Feet
Show depth and thickness of all water, oil and gas formations.

OIL, GAS OR WATER RECORDS

CASING RECORD

Formation	Content	From	To	Size	Put In	Pulled Out
				8-5/8"	347'	None

Describe in detail the manner in which the well was plugged, indicating where the mud fluid was placed and the method or methods used in introducing it into the hole. If cement or other plugs were used, state the character of same and depth placed, from ----- feet to ----- feet for each plug set.

4447' to 300' - heavy mud
300' to 200' - wood plug and 15 sacks cement
200' to 35' - heavy mud
35' to base of cellar - 10 sacks cement

(If additional description is necessary, use BACK of this sheet)

Correspondence regarding this well should be addressed to R. C. Cooper
Address Box 751
Great Bend, Kansas

STATE OF Kansas, COUNTY OF Barton, ss.
V. M. Conover (employee of owner) or (owner or operator) of the above-described well,
being first duly sworn on oath, says: That I have knowledge of the facts, statements, and matters herein contained and the log of the above-described well as filed and that the same are true and correct. So help me God.

(Signature) V. M. Conover
Box 751, Great Bend, Kansas
(Address)

SUBSCRIBED AND SWORN to before me this 20th day of December, 19 50

My commission expires March 12, 1951.

W. S. Smith
Notary Public.
STATE CORPORATION COMMISSION
DEC 29 1950 12-29-50
CONSERVATION DIVISION
Wichita, Kansas

PLUGGING
FILE SEC-14T 18-RUK
BOOK PAGE 49 LINE 23

WELL RECORD

Company..... Cities Service Oil Company Well No. 3 Farm Rosenbaum
 Location..... 660' North and 330' West of SE Corner Sec. 14 T. 28 R. 12W
 Elevation..... 1847 (1845 Gr.) County..... Pratt State..... Kansas
 Drlg. Comm. November 26, 1950 Contractor..... Holm Drilling Company
 Drlg. Comp. December 14, 1950 Acid..... None
 T. D. 4447' Initial Prod. None - Dry Hole (P. & A. 12-15-50)

CASING RECORD:

8-5/8" @ 340' con. 250 ex cement

FORMATION RECORD:

surface clay	0-70
sand & gravel	195
shale & shells	340
shale & sand	865
anhydrite	895
shale & shells	1300
salt & shale	1600
lime & shale	3210
lime	3420
lime & shale	3535
shale & lime	3670
lime & shale	3756
lime	3879
lime & shale	3925
lime	4085
lime & shale	4140
lime & chert	4175
lime, chert & shale	4191
lime	4247
lime & shale	4287
shale	4310
lime & chert	4340
chert & lime	4353
lime & chert	4377
lime	4447 T. D.

Top Lansing	3695'
Top Kinderhook	4185'
Top Viola	4317'
Top Simpson Shale	4418'
Top Simpson Sand	4426'
Total Depth	4447'

Drill stem test 3795-3823, rec.
90' mud in 30 mins., BHP 930#.

Drill stem test 4329-40, rec.
15' mud in 30 mins., BHP 0#.

Drill stem test 4427-31, rec.
9' slightly gas-cut mud in 30
mins., BHP 0#.

SYFO:	500'	1°
	1000'	0°
	1500'	0°
	2000'	0°
	2500'	0°
	3000'	0°
	3500'	0°
	4000'	1°

PLUGGING

FILE SEC 14 T 28 R 12W

BOOK PAGE 49 LINE 23