


WELL PLUGGING RECORD

Give All Information Completely  
Make Required Affidavit  
Mail or Deliver Report to:  
Conservation Division  
State Corporation Commission  
212 No. Market  
Wichita, Kansas

Pratt County, Sec. 15 Twp. 28 Rge. 12W (E) (W)

Location as "NE/CNW/SW" or footage from lines C E/2 SE SE  
Lease Owner West Supply Company  
Lease Name Chitwood Well No. 2  
Office Address Box 327 Chase, Kansas  
Character of Well (completed as Oil, Gas or Dry Hole) depleted - Oil  
Date well completed \_\_\_\_\_ 19\_\_\_\_  
Application for plugging filed \_\_\_\_\_ 19\_\_\_\_  
Application for plugging approved \_\_\_\_\_ 19\_\_\_\_  
Plugging commenced \_\_\_\_\_ 19\_\_\_\_  
Plugging completed January 15, 19 59  
Reason for abandonment of well or producing formation \_\_\_\_\_

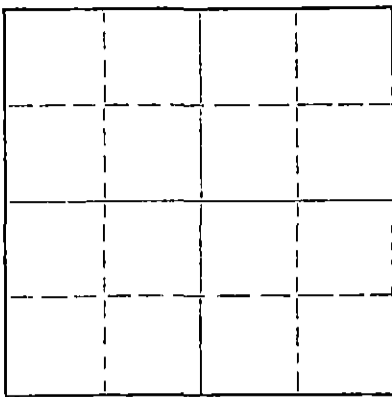

Locate well correctly on above Section Plat

If a producing well is abandoned, date of last production \_\_\_\_\_ 19\_\_\_\_  
Was permission obtained from the Conservation Division or its agents before plugging was commenced? yes

Name of Conservation Agent who supervised plugging of this well W. L. Lackamp  
Producing formation \_\_\_\_\_ Depth to top \_\_\_\_\_ Bottom \_\_\_\_\_ Total Depth of Well 450 Feet  
Show depth and thickness of all water, oil and gas formations.

OIL, GAS OR WATER RECORDS

CASING RECORD

FORMATION	CONTENT	FROM	TO	SIZE	PUT IN	PULLED OUT
					8 5/8" surface casing	

Describe in detail the manner in which the well was plugged, indicating where the mud fluid was placed and the method or methods used in introducing it into the hole. If cement or other plugs were used, state the character of same and depth placed, from \_\_\_\_\_ feet to \_\_\_\_\_ feet for each plug set.

321' of 8 5/8" surface casing circulated. Top Perf. 4377'  
Hole was sanded to 4362' and 5 sacks cement dumped with  
dump bailer. Pulled 1457' and bailed oil & water to 325'  
Filled hole to 325' with mud-set 10' rock bridge from  
325' with 20 sacks cement-poured top bridge. Mud to 35' Rock  
Bridge set to 30' with cement placed to base of cellar.

(If additional description is necessary, use BACK of this sheet)

Name of Plugging Contractor West Supply Company  
Address Box 327 Chase, Kansas

STATE OF Kansas COUNTY OF Sedgewick, ss.

(employee of owner) or (owner or operator) of the above-described well, being first duly sworn on oath, says: That I have knowledge of the facts, statements, and matters herein contained and the log of the above-described well as filed and that the same are true and correct. So help me God.

(Signature) [Signature]

Chase, Kansas (Address)

SUBSCRIBED AND SWORN TO before me this 1st day of July, 1959

Deward S. Greider (Signature)

My commission expires 11-5-67

Notary Public.

COPY


WELL LOG BUREAU KANSAS GEOLOGICAL SOCIETY  
412 Union National Bk Bldg., Wichita, Kansas

Company LION OIL CO.  
Farm John V. Chitwood No. 2

SEC. 15 T. 28 R. 12 W  
CE/2 SE SE

Total Depth. 4450'  
Comm 9-19-45 Comp. 10-17-45  
Shot or Treated. 500 Gals. acid.  
Contractor. Hissom & Wolfe Drlg. Co.  
issued. 4-27-46

County. Pratt  
KANSAS

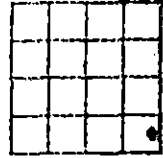

CASING:

8 5/8" 321' Cem.  
5 1/2" 4443' Cem.

Elevation. \_\_\_\_\_

Production. Phy. P6t. 539 Oil  
plus 58 BW.

Figures Indicate Bottom of Formations.

sand & red bed	0-321
red bed shale & shells	1185
shale & shells	1260
salt & shale	1420
shale & shells	1670
lime & shale	2160
sand	2195
shale & lime	2439
shale & shells	2586
shale & sand	2731
shale & shells	2870
shale & lime	3240
lime brkn	3310
lime shells & shale	3460
lime	3474
lime & shale	3670
lime	3674
lime & shale	3760
lime brkn	3830
lime	4228
lime & chert	4245
lime	4302
shale & lime	4370
lime	4390
lime & chert	4395
(Run Halliburton DS test 4390')	
(Run Halliburton DS test 4395')	
lime	4420
lime & shale	4434
lime	4450

Total Depth.

(Run Schlumberger 4450')

Tops:  
Viola 4373

Perf. 36/4377-81'

RECEIVED  
STATE CORPORATION COMMISSION

JAN 3 1959  
CONSERVATION DIVISION  
Wichita, Kansas

PLUGGING  
FILE SEC 15 T 28 R 12W  
BOOK PAGE 6 LINE 36