


STATE OF KANSAS  
STATE CORPORATION COMMISSION  
CONSERVATION DIVISION  
P. O. BOX 17027  
WICHITA, KANSAS 67217

FORM CP-4

WELL PLUGGING RECORD

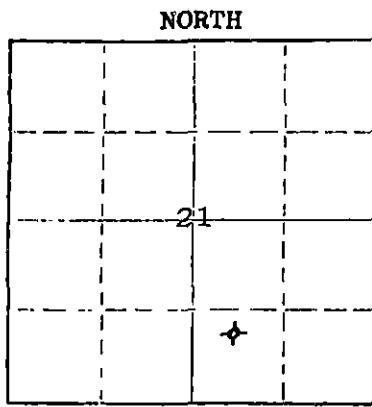

Locate well correctly on above Section Plat

Pratt County, Sec 21 Twp 28S Rge 12W (W)  
Location as "NE/CNW/SW" or footage from lines N/2 SW SE  
Lease Owner D. R. Lauck Oil Company, Inc.  
Lease Name Hayes Well No. 1  
Office Address 301 S. Broadway, Wichita, Kansas 67202  
Character of Well (completed as Oil, Gas or Dry Hole) Dry Hole  
Date well completed September 8, 1976  
Application for plugging filed September 8, 1976  
Application for plugging approved September 8, 1976  
Plugging commenced September 8, 1976  
Plugging completed September 8, 1976  
Reason for abandonment of well or producing formation Dry Hole

If a producing well is abandoned, date of last production 19  
Was permission obtained from the Conservation Division or its agents before plugging was commenced? Yes

Name of Conservation Agent who supervised plugging of this well G. Russell Biberstein  
Producing formation Depth to top Bottom Total Depth of Well 4520 Feet  
Show depth and thickness of all water, oil and gas formations.

OIL, GAS OR WATER RECORDS				CASING RECORD		
FORMATION	CONTENT	FROM	TO	SIZE	PUT IN	PULLED OUT
		0'	378'	8-5/8"	378'	None

Describe in detail the manner in which the well was plugged, indicating where the mud fluid was placed and the method or methods used in introducing it into the hole. If cement or other plugs were used, state the character of same and depth placed, from feet to feet for each plug set.

Spotted with 35 sacks cement at 300',  
15 sacks at 40', 5 sacks in rat hole.

SEP 27 1976  
09-27-76  
CONSERVATION DIVISION  
Wichita, Kansas

(If additional description is necessary, use BACK of this sheet)  
Name of Plugging Contractor Allied Cementing Co.  
Address Box 31, Russell, Kansas 67665

STATE OF KANSAS COUNTY OF SEDGWICK  
John D. Knightley (employee of owner) or (owner or operator) of the above-described well, being first duly sworn on oath, says: That I have knowledge of the facts, statements, and matters herein contained and the log of the above-described well as filed and that the same are true and correct. So help me God.

(Signature) [Signature]  
301 S. Broadway, Wichita, Kansas

SUBSCRIBED AND SWORN TO before me this 23rd day of September, 1976

My commission expires March 12, 1979 [Signature] Notary Public.

D. R. Lauck Oil Company, Inc. - Hayes #1  
N/2 SW SE Sec. 21-28S-12W  
Pratt County, Kansas

Contractor: D. R. Lauck Oil Company, Inc.  
301 S. Broadway  
Wichita, Kansas 67202

Commenced: August 8, 1976  
Completed: September 8, 1976

Drillers Log

Clay & Shale	150
Sand	235
Shale	385
Red Bed	420
Shale & Shells	1530
Shale & Lime Streaks	1795
Lime & Shale	2470
Shale & Lime	2630
Shale & Sand	2770
Shale	2783
Lime & Shale	2796
Shale	2853
Lime & Shale	2970
Shale & Lime	3082
Lime	3190
Lime & Shale	3800
Lime	4120
Shale & Lime	4169
Chert	4195
Lime	4520 RTD

SEP 27 1976  
WICHITA, KANSAS