

STATE OF KANSAS
STATE CORPORATION COMMISSION


Form CP-4

Give All Information Completely
Make Required Affidavit
Mail or Deliver Report to:
Conservation Division
State Corporation Commission
212 No. Market
Wichita, Kansas 67202

WELL PLUGGING RECORD

Pratt County, Sec. 22 Twp. 28 Rge. 12 (E) (W)

Location as "NE/CNW/SW" or footage from lines. NE 3/4, NE 1/4 SW
Lease Owner Raymond Oil Co., Inc.
Lease Name Chitwood J#4 Well No. _____
Office Address Wichita, Kansas 67202
Character of Well (completed as Oil, Gas or Dry Hole) _____
Date well completed _____ 19____
Application for plugging filed _____ 19____
Application for plugging approved _____ 19____
Plugging commenced 3/3/70 _____ 19____
Plugging completed 3/7/70 _____ 19____
Reason for abandonment of well or producing formation depleted.

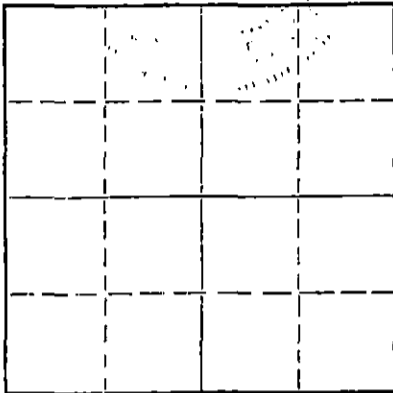

Locate well correctly on above Section Plat

If a producing well is abandoned, date of last production _____ 19____
Was permission obtained from the Conservation Division or its agents before plugging was commenced? yes

Name of Conservation Agent who supervised plugging of this well Biberstein
Producing formation _____ Depth to top _____ Bottom _____ Total Depth of Well 4410 Feet
Show depth and thickness of all water, oil and gas formations.

OIL, GAS OR WATER RECORDS

CASING RECORD

FORMATION	CONTENT	FROM	TO	SIZE	PUT IN	PULLED OUT
				8-5/8	381	none
				5 1/2	4396'	3016'

Describe in detail the manner in which the well was plugged, indicating where the mud fluid was placed and the method or methods used in introducing it into the hole. If cement or other plugs were used, state the character of same and depth placed, from _____ feet to _____ feet for each plug set.

Checked hole to 4410', ran sand to 4375' and ran 5 sacks of cement.
Shot pipe at 3217', pumped load of water, had 800 lb. pressure, pumped load oil and 2 loads water. Shot pipe at 3100', 3008', pumped three loads water and worked pipe loose, pulled 98 joints. Bailed hole to 250' and set 10' rock bridge and ran 25 sacks of cement. Mudded hole to 40', set 10' rock bridge and ran 10 sacks of cement. Tallied pipe.

PLUGGING COMPLETE.

RECEIVED
STATE CORPORATION COMMISSION
MAR 18 1970
CONSERVATION DIVISION
Wichita, Kansas


(If additional description is necessary, use BACK of this sheet)

Name of Plugging Contractor KNIGHT CASING PULLING CO., INC.
Address CHASE, KANSAS

STATE OF KANSAS, COUNTY OF RICE, ss.
NOEL J. KNIGHT (employee of owner) or (owner or operator) of the above-described well, being first duly sworn on oath, says: That I have knowledge of the facts, statements, and matters herein contained and the log of the above-described well as filed and that the same are true and correct. So help me God.

(Signature) Noel Knight
CHASE, KANSAS
(Address)

Subscribed and sworn to before me this 10th day of March, 19 70

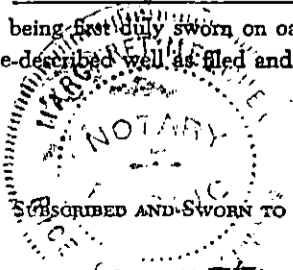

Margaret Melcher
Notary Public.

My commission expires 2/15/71

LION OIL CO., EL DORADO, ARK.
INDIVIDUAL WELL RECORD

PAGE NO. 1

GENERAL INFORMATION

FORM NO. 176 - PAGE 1 TONEY PIG. & STATY CO.

Operator Lion Oil Co. Lease Chitwood Unit Well No. J-4

Lease No. _____ Sec. 22 Twp. 28S Rge. 12W County Pratt State Kansas

Location NE/4 ^{SW} NE/4 NE/4 Field or Pool Chitwood

990' from S line and 990' from W line.

Elevation D. F. 1868' Elevation Rot. Bushing _____

Contractor Ruso Drilling Company

Drilling Began 8/9/44 Drilling Ended 9/16/44

Maximum Deviation of Hole 1 degree

Rotary Tool Footage 4398' Cable Tool Footage 12'

Drillers T. D. 4410' Schlumberger T. D. _____

		X	
		22	

RECEIVED
 STATE CORPORATION COMMISSION
 FEB 10 1970
 CONSERVATION DIVISION
 Wichita, Kansas

Total Depth Corrections _____

Float Collar Size 5 1/2" Set at _____ Guide Shoe Set at 4396' (From Rotary Bushing)

Total Depth Drilled out to 4410' (From Rotary Bushing)

Remarks _____

CASING AND LINER RECORD

SIZE O. D.	GRADE	WEIGHT	NO. JOINTS	AMOUNT	MANUFACTURER	THREAD	CEMENT		
							SACKS	WT.	KIND
8-5/8"	H-40 SS	28#	12	381'	Set at 384'	8 rd	200	w/8	sxs aquagel
5 1/2"	H-40 SS	14#	145	4432'	Set at 4396'	8 rd	200	w/4	sxs aquagel