


STATE OF KANSAS
STATE CORPORATION COMMISSION

Form CP-4

WELL PLUGGING RECORD

Give All Information Completely
Make Required Affidavit
Mail or Deliver Report to:
Conservation Division
State Corporation Commission
212 No. Market
Wichita, Kansas

NORTH

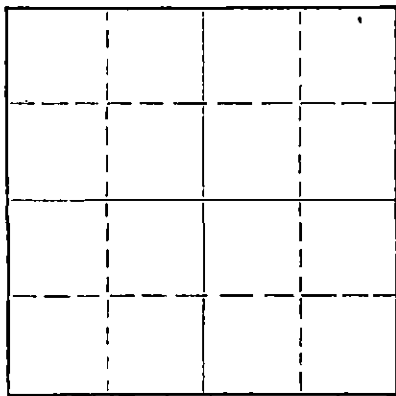

Locate well correctly on above
Section Plat

Pratt County, Sec. 22 Twp. 28 Rge. 12 (X) (W)
Location as "NE/CNW/SW" or footage from lines NE SE SW
Lease Owner Raymond Oil Co.
Lease Name Chitwood Well No. F-2
Office Address Wichita, Kans.
Character of Well (completed as Oil, Gas or Dry Hole)
Date well completed 19____
Application for plugging filed 19____
Application for plugging approved 19____
Plugging commenced 19____
Plugging completed October 8 19 69
Reason for abandonment of well or producing formation _____

If a producing well is abandoned, date of last production 19____
Was permission obtained from the Conservation Division or its agents before plugging was commenced? Yes
Ralph Warren

Name of Conservation Agent who supervised plugging of this well
Producing formation _____ Depth to top _____ Bottom _____ Total Depth of Well _____ Feet
Show depth and thickness of all water, oil and gas formations.

OIL, GAS OR WATER RECORDS

CASING RECORD

FORMATION	CONTENT	FROM	TO	SIZE	PUT IN	PULLED OUT

RECEIVED
STATE CORPORATION COMMISSION
OCT 17 1969
CONSERVATION DIVISION
Wichita, Kansas

Describe in detail the manner in which the well was plugged, indicating where the mud fluid was placed and the method or methods used in introducing it into the hole. If cement or other plugs were used, state the character of same and depth placed, from _____ feet to _____ feet for each plug set.

Filled back to 4390' with sand and dumped 5 sacks of cement.

Shot pipe off at 2486.70'. Pulled pipe and mudded hole to 250'. Set 10' rock bridge and dumped 25 sacks of cement.

Mudded to 40' and set 10' rock bridge. Finished with 10 sacks of cement at base of cellar.

Name of Plugging Contractor Bert Self (If additional description is necessary, use BACK of this sheet)
Address Hutchinson, Kans.


STATE OF Kans. COUNTY OF Reno, ss.
Employee (employee of owner) or (owner or operator) of the above-described

well, being first duly sworn on oath, says: That I have knowledge of the facts, statements, and matters herein contained and the log of the above-described well as filed and that the same are true and correct. So help me God.

(Signature) Bert Self
R. R. #4, Hutchinson, Kans. (Address)

SUBSCRIBED AND SWORN TO before me this 11th day of October, 19 69

My commission expires October 18, 1969 Notary Public.

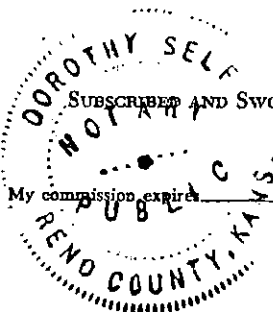

NE SE SW

Sec. 22-28S-12W

Pratt County, Kansas

Fissell No. 1

Contractor: Corbett-Barbour Drilling Company

Started: April 1, 1944

finished: May 16, 1944

Clay and Sand	0' - 235'	
Red Bed and Shale	350	10-3/4" casing @ 350' w/200 Sacks
Red Bed and Shells	900	
Shale and Lime Shells	1025	
Shale and Shells	1195	
Shale, Shells and Salt	1520	Straight hole test @ 1450' - OK
Shale and Lime Shells	1685	
Broken Lime	1750	
Lime	2055	Straight hole test @ 2000' - OK
Lime and Shale	2250	
Shale	2275	
Lime and Shale	2290	
Shale and Lime	2385	
Lime and Shale	2580	
Shale and Lime	2650	
Lime, Broken	2752	
Shale	2785	
Shale and Lime	2820	
Lime and Shale	2907	Straight hole test @ 2900' - OK
Shale and Lime	3155	
Lime and Shale	3280	
Lime	3362	
Shale and Lime	3390	
Lime and Shale	3465	
Lime	3522	
Lime and Shale	3608	
Lime	3670	
Lime and Shale	3709	
Shale	3710	
Lime	3734	
Shale and Lime	3755	
Lime	4116	Straight hole test @ 4000' - OK
Shale	4130	
Shale and Lime	4165	
Shale, Chert, and Lime	4195	
Shale	4210	
Shale and streaks sandy lime	4241	
Shale	4288	
Shale and Lime	4320	
Lime and Chert	4338	
Shale and Lime	4361	
Lime	4363	
Lime and Shale	4383	
Lime	4409	R. T. D. 5-1/2" casing @ 4404' w/400 sack

RECEIVED
STATE CORPORATION COMMISSION
AUG 25 1969
CONSERVATION DIVISION
Wichita, Kansas

STATE OF KANSAS) ss.
COUNTY OF PRATT)

I, Vernon Hayes, do hereby certify that the above log is true and correct to the best of my knowledge and belief.

Vernon Hayes

Subscribed and sworn to before me this 24th Day of June, 1954.

Van Duerbeck
Notary Public

My Commission Expires August 29, 1955.